

APPENDIX 3.5-G

Geologic Logs, Well Construction Diagrams, and Well
Development Forms for Permeability Test Wells, 1988

LOG OF TEST BORING NO.: TW - K1										SURFACE ELEVATION: 1102.5 Feet	
CLIENT: Kennecott PROJECT: Rock Permeability PROJECT NUMBER: 87K10 - W066 LOCATION: River pillar, about 80' E. of PZ - S1 COORDINATES: N40043.59, E38784.33										BORING DEPTH: 193.0 Feet	
										DATE: 03-07-88	
MSL ELEV	DEPTH FR LND SURF	SAMP DEPTH INTERVAL	TYPE	#	N	REC (ft)	DESCRIPTION OF MATERIAL	CLASS	LABORATORY TESTS	DRILLING AND SAMPLING NOTES	
1102.5	--0						Drilled wo/sampling 0 - 28' Bldrs 0 - 8'; 10 - 15' Cuttings redbrown SILTY SAND	SM			
1082.5	--20						At 20', lt. yel brn SILT, soft, altered schist. Rock soft to about 44 ft.	ML			
1062.5	--40	33'-43'	*g								
		43'-63'	g								
1042.5	--60	53'-63'	g				Cuttings predominantly powder with few chips, dry.				
		63'-73'	g				Gray, red, green biotite schist.				
1022.5	--80	73'-83'	g								
		83'-93'	g				Biotite-quartz-chlonite schist and biotite-chlorite-quartz-sericite schist	PC (2c), (2a)			
1002.5	--100	93'-103'	g								
		103'-113'	g								
982.5	--120	113'-123'	g								
		123'-133'	g								
962.5	--140	133'-143'	g								
		143'-153'	g								
942.5	--160	153'-163'	g								
		163'-173'	g								
922.5	--180	173'-183'	g								
		183'-193'	g								
902.5	--200						=====				
							EOB at 193' in biotite schist.			*g=grab samples of cuttings.	
882.5	--220										

DRILLING DATA

START DATE: 03/07/88
 COMPLETION DATE: 03/07/88
 LOGGED BY: BJS
 DRILLING METHOD: Mud rotary 0-28'; air 28-193'
 DRILLING CONTRACTOR: Luisier Drilling, Inc.

WATER LEVEL INFORMATION

DEPTH AT COMPLETION: DRY
 LATER TIME/DEPTH: 03-08-88
 LATER TIME/DEPTH: 7:55 AM/117'
 CAVE IN DEPTH: 185'
 DRILLING LOSSES:

MONITORING WELL CONSTRUCTION DIAGRAM

WELL NO: TW-K1 CLIENT: Kennecott
 DATE INSTALLED: 3-7-88 PROJECT: Rock permeability
 DRILLER: Luisier Drilling, Inc. SCOPE I.D.: 87K10-W.O. 66
 DRILLING METHOD: Mud rotary, air BY: BJS


PROTECTOR PIPE:
 SIZE 6"
 MATERIAL Steel
 LOCK NO. Master 3377

DRILL HOLE DIAMETER 9" tricone 0-28'
6" downhole air hammer 28-193'

PIPE:
 DIAMETER 6"
 MATERIAL Steel
 SCH. -
 TYPE OF JOINTS Welded

SCREEN: Open hole
 DIAMETER 6"
 SLOT SIZE -
 LENGTH 157'

TYPE OF CAP -

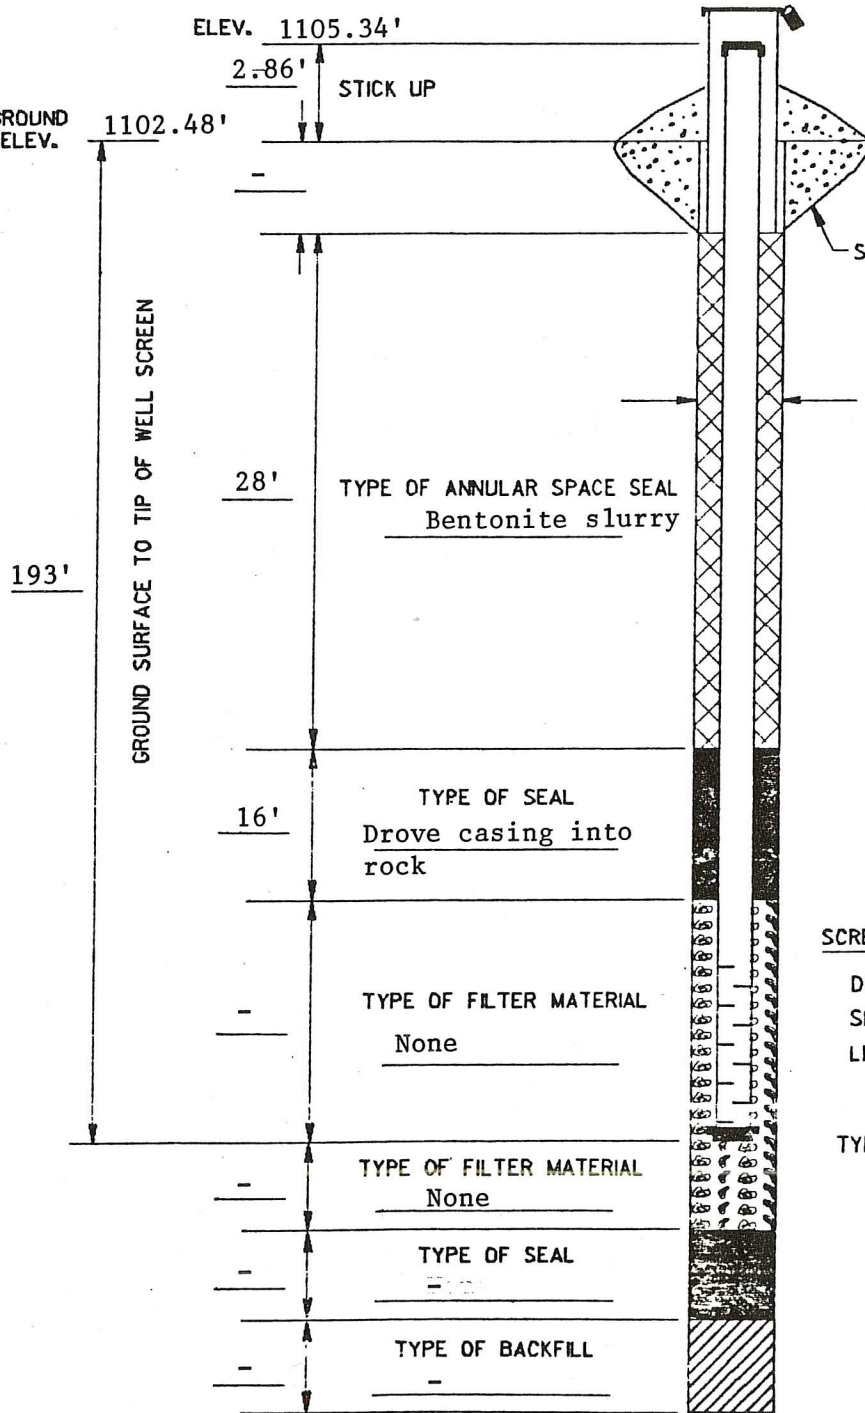

Foth & Van Dyke
 Geosciences & Environmental
 Management Division
 Revised 3/88 By BJS
 Drawn By MRS

MONITORING WELL DEVELOPMENT

WELL NUMBER TW-K1 CLIENT Kennecott
 WELL DIAMETER 6" PROJECT Rock permeability
 TOTAL DEPTH OF WELL 193' SCOPE I.D. 87K10-W.O. 66
 DEPTH TO WATER _____ TIME OF MEASUREMENT _____ BY BJS
 BEFORE 23.85' 1:35 p.m. DATE 3-9-88
 AFTER Dry 2:08 p.m.

DESCRIPTION OF DEVELOPMENT METHOD

Well was dry on completion on 3-7-88.
 On 3-9-88, well was surged with cable tool rock bailer
 (13' x 4.5" OD) for 8 min., then bailed dry.

VOLUME OF WATER REMOVED FROM WELL Approx. 250 gals.
 CLARITY OF WATER IN WELL BEFORE DEVELOPMENT Red brn. silty
 CLARITY OF WATER IN WELL AFTER DEVELOPMENT Red brn. silty
 PRESENCE OF SEDIMENT AT THE BOTTOM OF THE WELL Silt
 VOLUME OF WATER ADDED TO WELL None
 SOURCE OF WATER ADDED TO WELL -
 TIME SPENT FOR DEVELOPMENT 0.8 hrs.

STABILIZATION READINGS

GAL. REMOVED	TIME	TEMPERATURE	FIELD	
			SPEC. COND.	pH
_____	_____	_____	_____	_____
_____	_____	_____	_____	_____
_____	_____	_____	_____	_____
_____	_____	_____	_____	_____


FOTH AND VAN DYKE

LOG OF TEST BORING NO.: TW - K2 (PZ - K2P, PZ - K2PP)							SURFACE ELEVATION: 1102.3 Feet			
CLIENT: Kennecott PROJECT: Rock Permeability PROJECT NUMBER: 87K10 - W066 LOCATION: River pillar, about 40' SW of baseline. COORDINATES: N39750.05, E39015.57							BORING DEPTH: 193.0 Feet			
							DATE: 03-08-88			
MSL ELEV	DEPTH FR LND SURF	SAMP DEPTH INTERVAL	TYPE	#	N	REC (ft)	DESCRIPTION OF MATERIAL	CLASS	LABORATORY TESTS	DRILLING AND SAMPLING NOTES
1102.3	--0						Drilled w/sampling to 30' Red brn silty SAND w/grl.	SM		
1082.3	--20	30'-32'	*g				Bright red, soft, gossan.	PC(6)		
1062.3	--40						Dk gray massive sulfide, w/chert band at 30', hard, 0.5-1 gpm water.	(1c)		
1042.3	--60	63'-73'	g				White metachert, w/copper oxides coatings, v. hard, 10-15 gpm water @ 63'.	(1b)		
1022.3	--80	73'-83'	g				Biotite-sericite-quartz-chlorite-schist.			
1002.3	--100	83'-93'	g							
982.3	--120	93'-103'	g							
962.3	--140	103'-113'	g					(2a)		
942.3	--160	113'-123'	g							
922.3	--180	123'-133'	g							
902.3	--200	133'-143'	g							
882.3	--220	143'-153'	g							
		153'-163'	g							
		163'-173'	g							
		173'-183'	g							
		183'-193'	g							
							EOB at 193' in biotite schist.			*g=grab samples of cuttings.

DRILLING DATA	WATER LEVEL INFORMATION
START DATE: 03/08/88	DEPTH AT COMPLETION: 17.25 Feet
COMPLETION DATE: 03/08/88	LATER TIME/DEPTH:
LOGGED BY: BJS	LATER TIME/DEPTH:
DRILLING METHOD: Mud rotary 0-30'; air 30-193'	CAVE IN DEPTH:
DRILLING CONTRACTOR: Luisier Drilling, Inc.	DRILLING LOSSES:

MONITORING WELL CONSTRUCTION DIAGRAM

WELL NO: TW-K2 CLIENT: Kennecott
 DATE INSTALLED: 3-8-88 PROJECT: Rock permeability
 DRILLER: Luisier Drilling, Inc. SCOPE I.D.: 87K10-W.O. 66
 DRILLING METHOD: Mud rotary, air BY: BJS

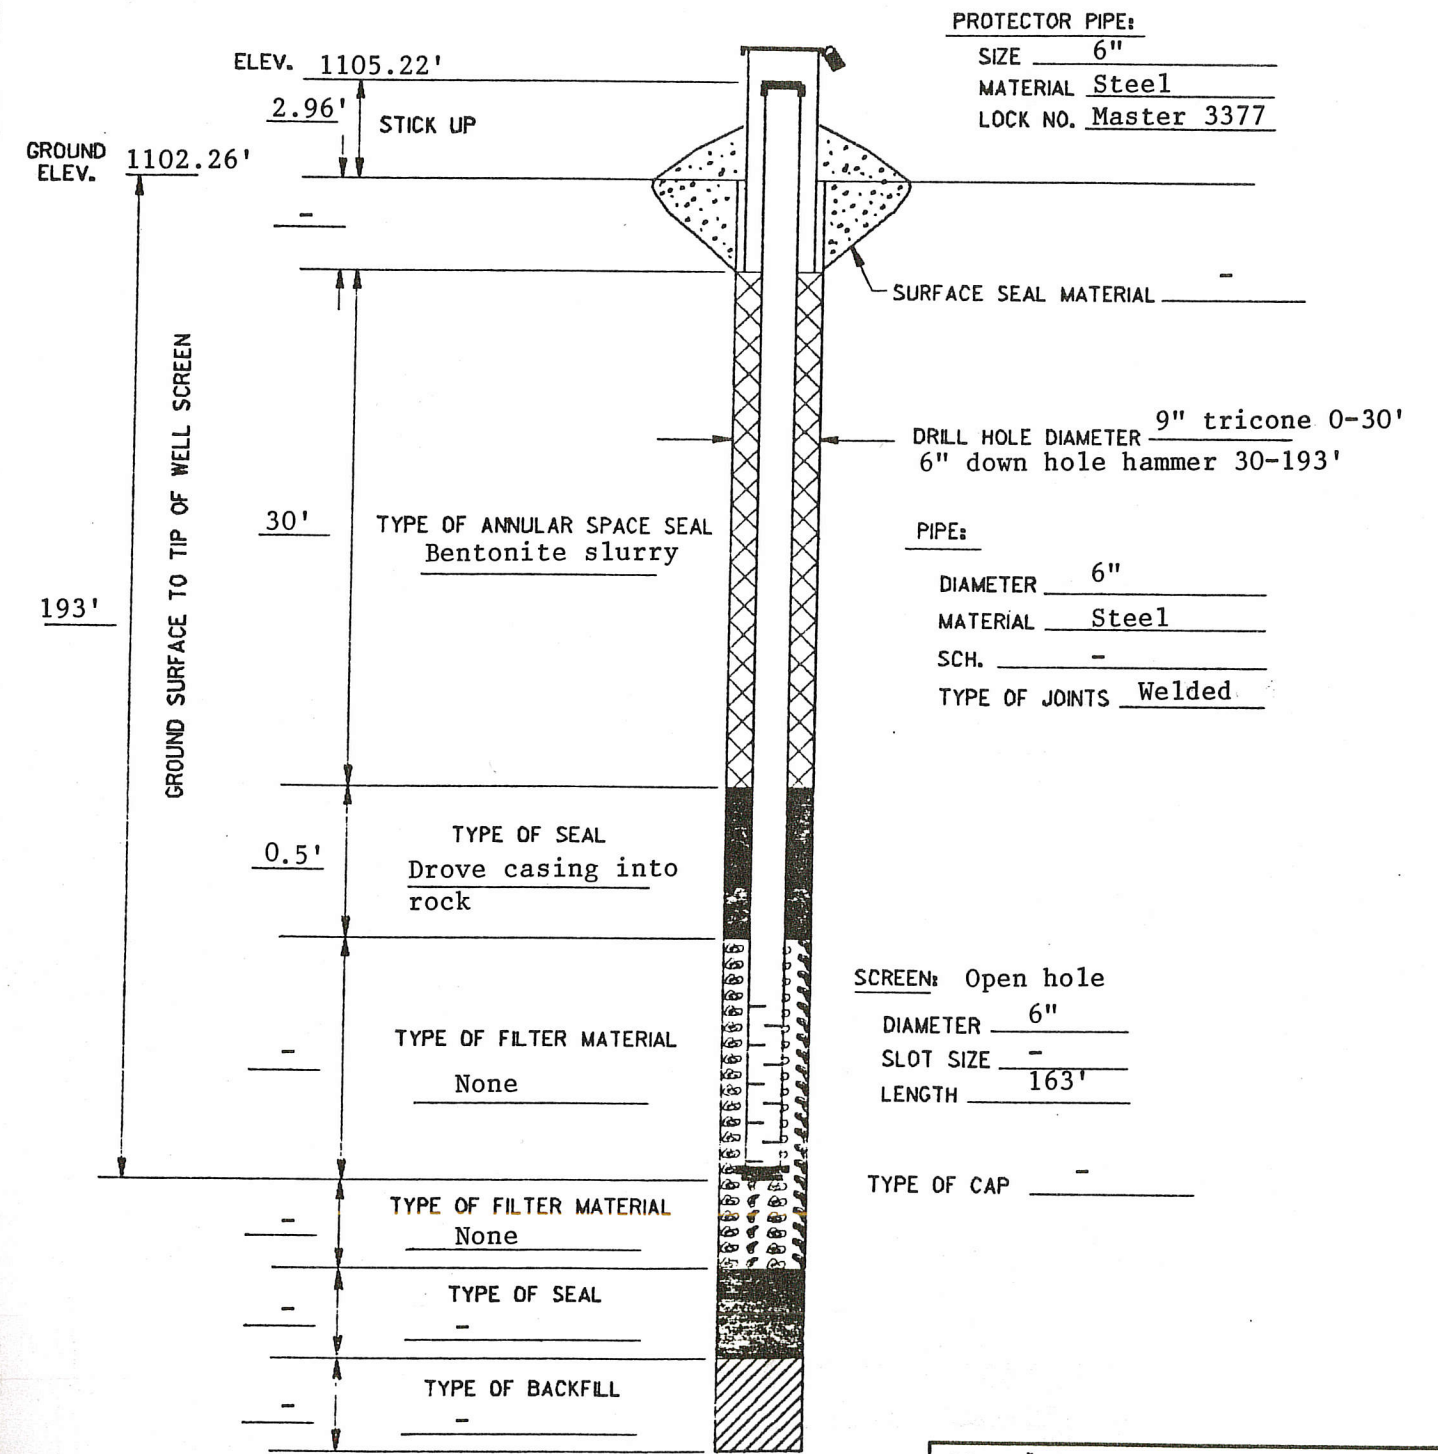

Foth & Van Dyke
 Geosciences & Environmental
 Management Division
 Revised 3/88 By BJS
 Drawn By MRS

MONITORING WELL DEVELOPMENT

WELL NUMBER TW-K2 CLIENT Kennecott
 WELL DIAMETER 6" PROJECT Rock permeability
 TOTAL DEPTH OF WELL 193' SCOPE I.D. 87K10-W.O. 66
 DEPTH TO WATER TIME OF MEASUREMENT BY BJS
 BEFORE 13.4' 3:25 p.m. DATE 3-9-88
 AFTER 26.4' 3:40 p.m.

DESCRIPTION OF DEVELOPMENT METHOD

At completion on 3-6-88, blew out about 10 gpm for 10 min.
 On 3-9-88, well was surged with cable tool rock bailer (13' x 4.5" OD)
 for 11 min., then bailed down to static water level.

VOLUME OF WATER REMOVED FROM WELL Approx. 170 gal. (total)
 CLARITY OF WATER IN WELL BEFORE DEVELOPMENT Red brn. silty
 CLARITY OF WATER IN WELL AFTER DEVELOPMENT Lt. red brn., slightly silty
 PRESENCE OF SEDIMENT AT THE BOTTOM OF THE WELL Silt
 VOLUME OF WATER ADDED TO WELL None
 SOURCE OF WATER ADDED TO WELL -
 TIME SPENT FOR DEVELOPMENT 1 hr.

STABILIZATION READINGS

GAL. REMOVED	TIME	FIELD		
		TEMPERATURE	SPEC. COND.	pH
_____	_____	_____	_____	_____
_____	_____	_____	_____	_____
FOTH AND VAN DYKE

LOG OF TEST BORING NO.: TW - K3, TW - K3R

CLIENT: Kennecott
 PROJECT: Rock Permeability
 PROJECT NUMBER: 87K10 - W066
 LOCATION: Sec. 410, about 150' SW.
 COORDINATES: N40,350.49 E39,746.34

SURFACE ELEVATION: 1124.6 Feet
 BORING DEPTH: 163.0 Feet
 DATE: 03-06-88

MSL ELEV	DEPTH FR LND SURF	SAMP DEPTH INTERVAL	TYPE	#	N	REC (ft)	DESCRIPTION OF MATERIAL	CLASS	LABORATORY TESTS	DRILLING AND SAMPLING NOTES
1124.6	--0						Drilled w/sampling to 38' Red brn silty SAND w/grl.	SM		
1104.6	--20						Lt. brn sandstone.	SP		
1084.6	--40	38'-43'	*g				Lt. yel. brn SILT, altered biotite schist, moist	ML		
		43'-53'	g				Cuttings mostly powder.			
1064.6	--60	53'-63'	g				Biotite schist, interbedded biotite-quartz-chlorite schist and biotite-sericite quartz-chlorite schist.	PC		
		63'-73'	g							
1044.6	--80	73'-83'	g							
		83'-93'	g							
1024.6	--100	93'-103'	g				At about 100', cuttings hematitic, moist, sticky.	(2a)		
		103'-113'	g							
1004.6	--120	113'-123'	g				EOB at 163' in biotite schist.	(2c)		Drilled with air and water from 113'.
		123'-133'	g							
984.6	--140	133'-143'	g							
		143'-153'	g							
964.6	--160	153'-163'	g							
944.6	--180		g							
924.6	--200		g							
904.6	--220									

DRILLING DATA

START DATE: 03/06/88
 COMPLETION DATE: 03/06/88
 LOGGED BY: BJS
 DRILLING METHOD: Mud rotary 0-38'; air 38-163'
 DRILLING CONTRACTOR: Luisier Drilling, Inc.


WATER LEVEL INFORMATION

DEPTH AT COMPLETION:
 LATER TIME/DEPTH: 03-07-88
 LATER TIME/DEPTH: 7:30AM/14.2'
 CAVE IN DEPTH: 123'
 DRILLING LOSSES:

*g=grab samples of cuttings.

MONITORING WELL CONSTRUCTION DIAGRAM

WELL NO: TW-K3 CLIENT: Kennecott
 DATE INSTALLED: 3-6-88 PROJECT: Rock permeability
 DRILLER: Luisier Drilling, Inc. SCOPE I.D.: 87K10-W.O. 66
 DRILLING METHOD: Mud rotary, air BY: BJS

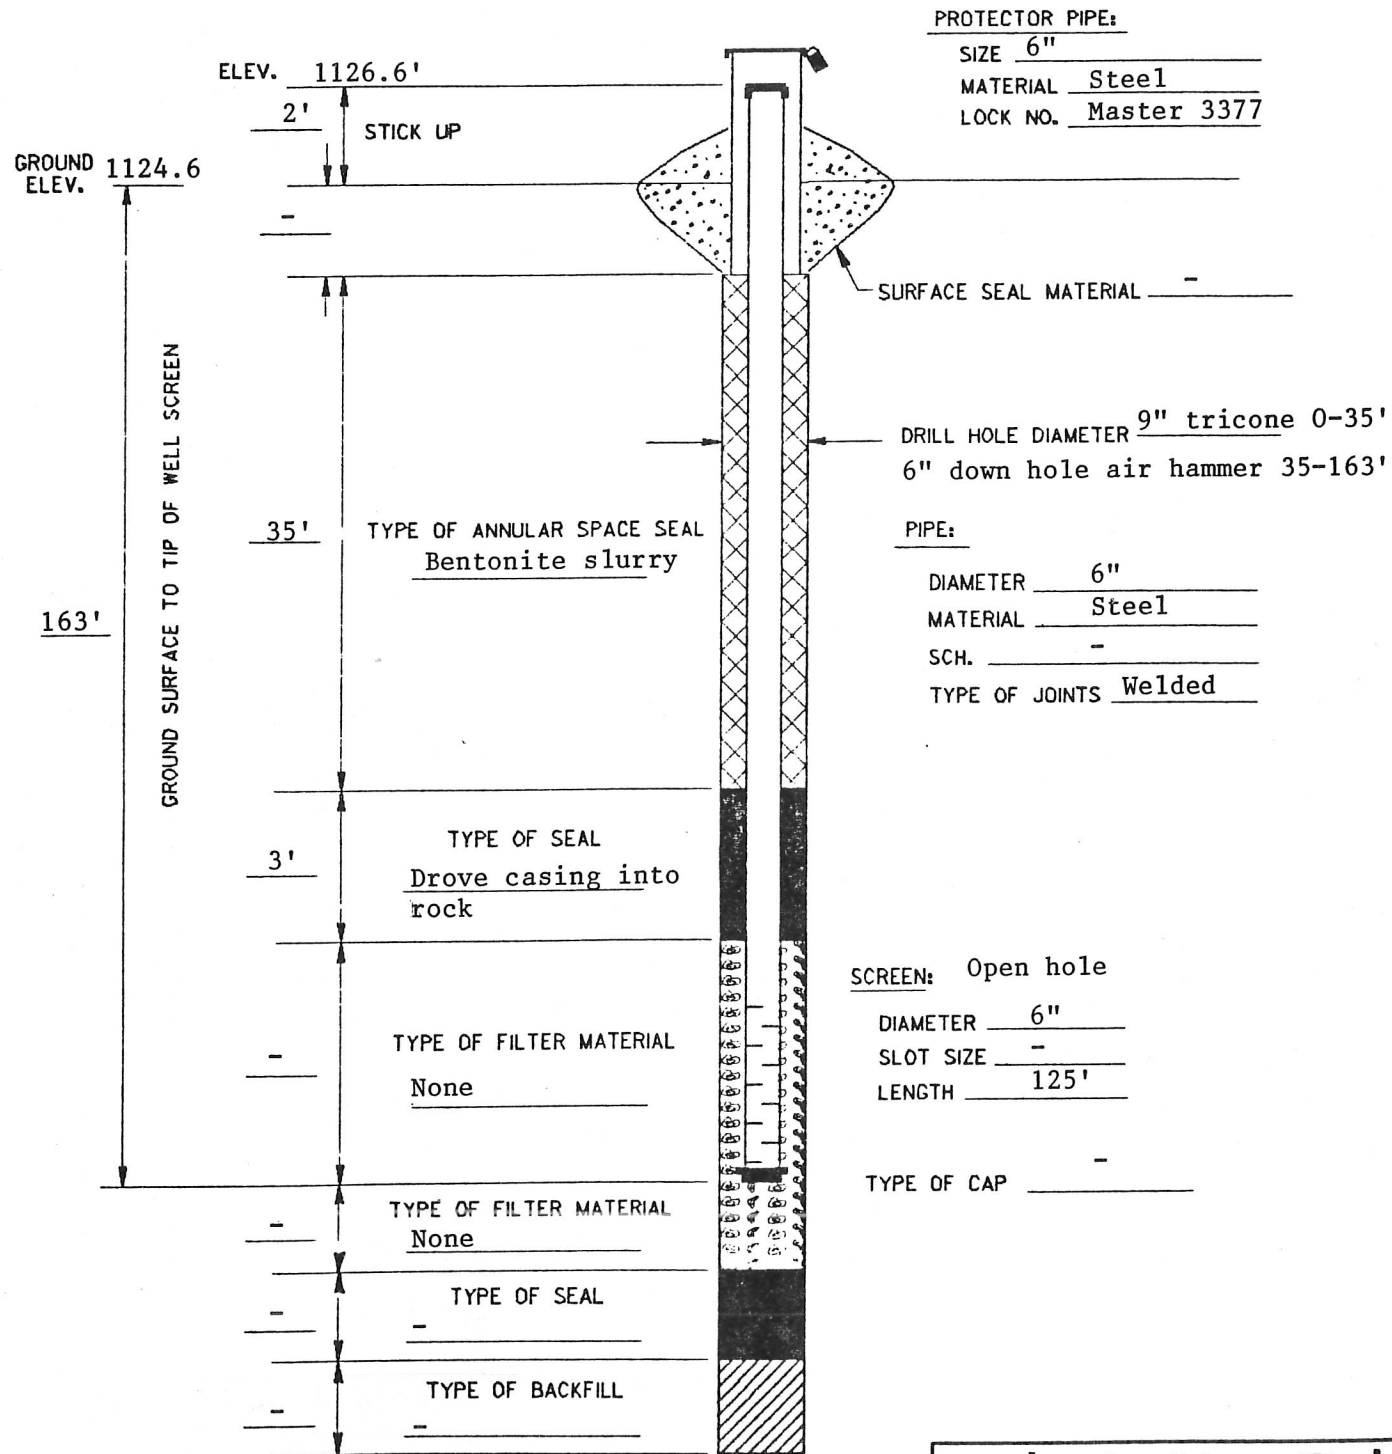

Foth & Van Dyke
 Geosciences & Environmental
 Management Division
 Revised 3/88 By BJS
 Drawn By MRS

MONITORING WELL DEVELOPMENT

WELL NUMBER TW-K3 CLIENT Kennecott
 WELL DIAMETER 6" PROJECT Rock permeability
 TOTAL DEPTH OF WELL 163' SCOPE I.D. 87K10-W.O. 66
 DEPTH TO WATER 12.5' TIME OF MEASUREMENT 8:33 a.m. BY BJS
 BEFORE 12.5' AFTER 114' DATE 3-9-88
 TIME OF MEASUREMENT 9:12 a.m.

DESCRIPTION OF DEVELOPMENT METHOD

At completion on 3-6-88, blew out 0.5-1 gpm for 25 min.
 On 3-9-88, well was surged with cable tool rock bailer (13' x 4.5" OD) for 5 min., then bailed down to 114 ft.

At 10:12 to 10:20 a.m. bailed out an additional 80 gals.
 At 10:12 a.m. DTW = 14 ft.
 At 10:20 a.m. DTW = 90 ft.

VOLUME OF WATER REMOVED FROM WELL Approx. 350 gals. (total)
 CLARITY OF WATER IN WELL BEFORE DEVELOPMENT Red brn., silty
 CLARITY OF WATER IN WELL AFTER DEVELOPMENT Lt. red brn., slightly silty
 PRESENCE OF SEDIMENT AT THE BOTTOM OF THE WELL Silt
 VOLUME OF WATER ADDED TO WELL None
 SOURCE OF WATER ADDED TO WELL -
 TIME SPENT FOR DEVELOPMENT 1 hr.

STABILIZATION READINGS

GAL. REMOVED	TIME	FIELD		
		TEMPERATURE	SPEC. COND.	pH
_____	_____	_____	_____	_____
_____	_____	_____	_____	_____
FOTH AND VAN DYKE

MONITORING WELL CONSTRUCTION DIAGRAM

WELL NO: TW-K3R
 DATE INSTALLED: 3-23-88
 DRILLER: Luisier Drilling, Inc.
 DRILLING METHOD: Mud rotary, air

CLIENT: Kennecott
 PROJECT: Rock permeability
 SCOPE I.D.: 87K10-W.O. 66
 BY: BJS


PROTECTOR PIPE:
 SIZE 6"
 MATERIAL Steel
 LOCK NO. Master 3377

Outer PIPE:
 DIAMETER 6"
 MATERIAL Steel
 SCH. -
 TYPE OF JOINTS Welded

Inner Pipe:
 Diameter 4"
 Material PVC
 Sch. -
 Type of joints Flush threaded

SCREEN:
 DIAMETER 4"
 SLOT SIZE 40
 LENGTH 108' (alternating 10' lengths of screen and pipe)

TYPE OF CAP PVC

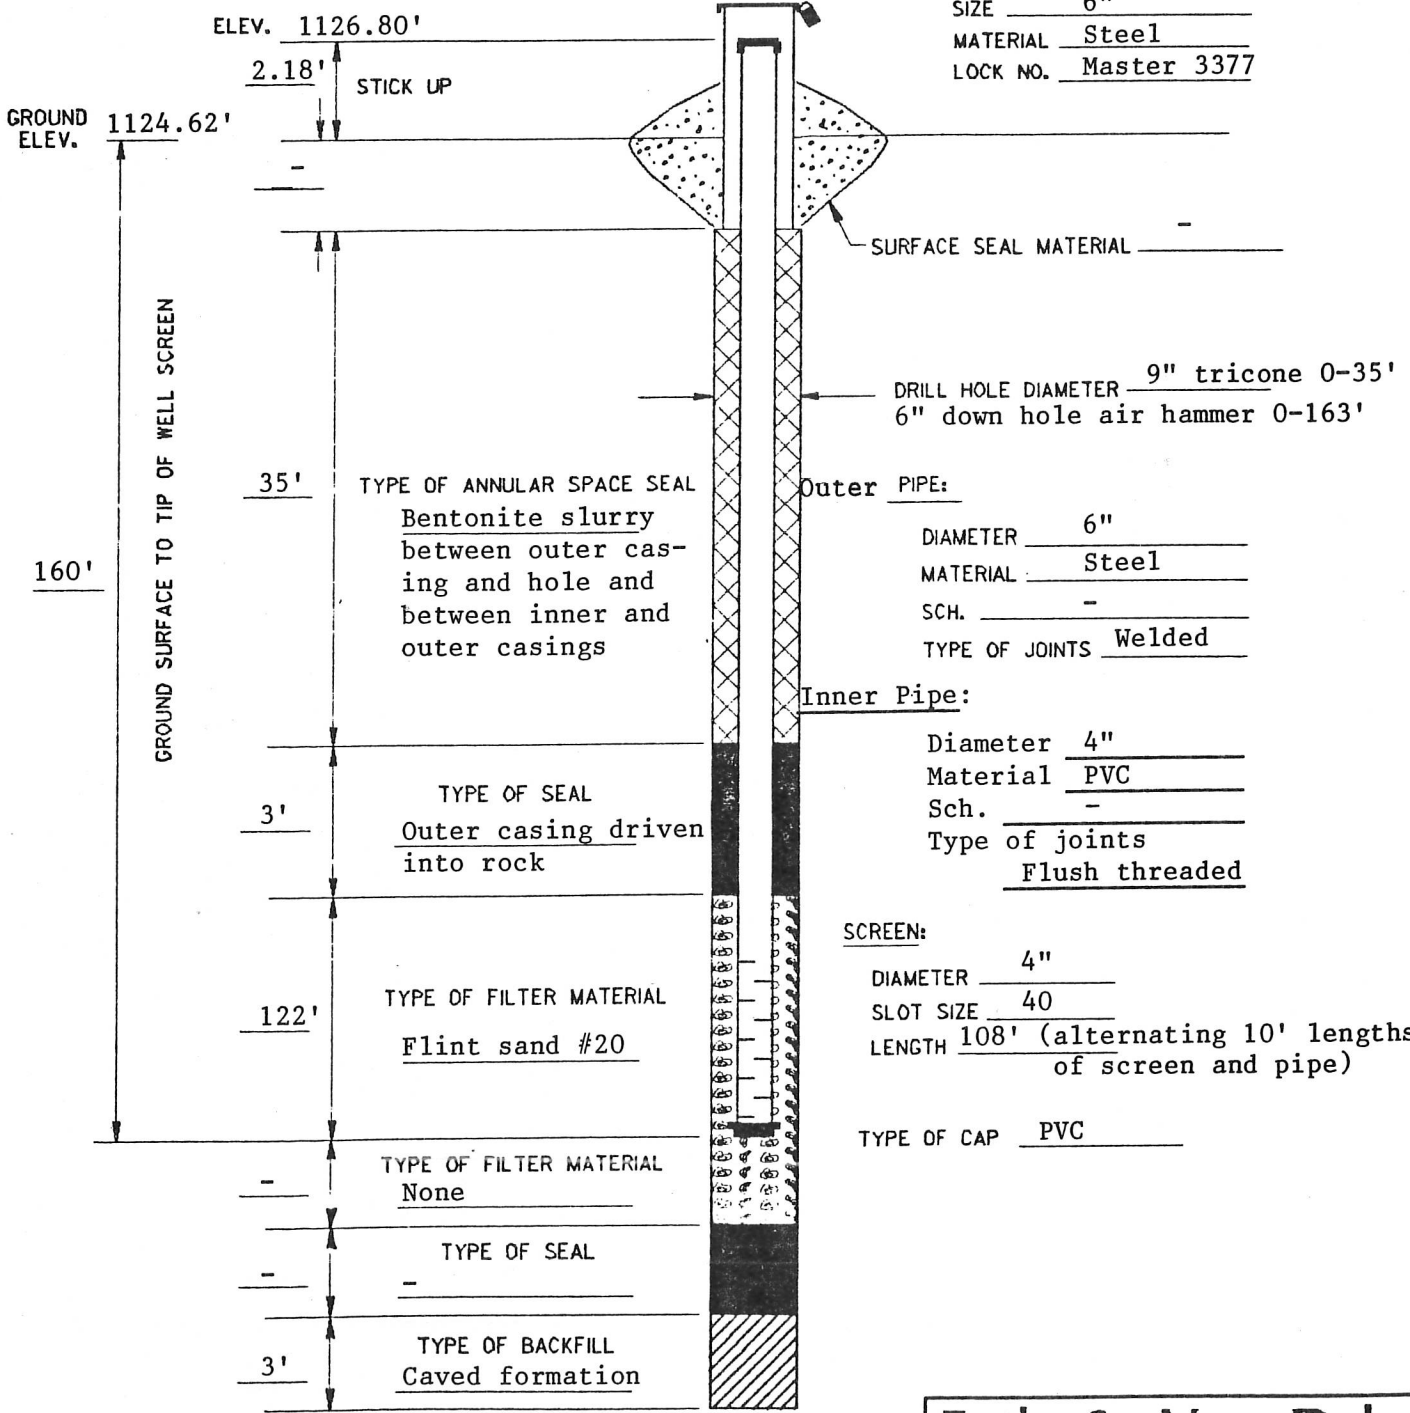

Note: TW-K3R was installed in open hole well TW-K3. Hole had caved to 120 feet and was redrilled to 163 feet.

Foth & Van Dyke
 Geosciences & Environmental
 Management Division
 Revised 3/88 By BJS
 Drawn By MRS

MONITORING WELL DEVELOPMENT

WELL NUMBER TW-K3R CLIENT Kennecott
 WELL DIAMETER 4" PROJECT Rock permeability
 TOTAL DEPTH OF WELL 160' SCOPE I.D. 87K10-W.O. 66
 DEPTH TO WATER _____ TIME OF MEASUREMENT BY BJS
 BEFORE _____ - _____ DATE 3-23-88
 AFTER _____ - _____

DESCRIPTION OF DEVELOPMENT METHOD

At completion of drilling, blew out 1 to 1.5 gpm from open hole from 12:45 p.m. to 1:15 p.m.
 Set 40 ft. of A-rod in 4" PVC well and surged with air for 5 min.
 Blew out about 1 gpm from 5:00 p.m. to 5:20 p.m.

VOLUME OF WATER REMOVED FROM WELL Approx. 60 gals. (total)
 CLARITY OF WATER IN WELL BEFORE DEVELOPMENT Red brn., silty
 CLARITY OF WATER IN WELL AFTER DEVELOPMENT Lt. red brn., slightly silty
 PRESENCE OF SEDIMENT AT THE BOTTOM OF THE WELL Silt
 VOLUME OF WATER ADDED TO WELL None
 SOURCE OF WATER ADDED TO WELL -
 TIME SPENT FOR DEVELOPMENT 0.8 hrs.

STABILIZATION READINGS

GAL. REMOVED	TIME	TEMPERATURE	FIELD	
			SPEC. COND.	pH
_____	_____	_____	_____	_____
_____	_____	_____	_____	_____
_____	_____	_____	_____	_____
_____	_____	_____	_____	_____

FOTH AND VAN DYKE

MONITORING WELL CONSTRUCTION DIAGRAM

WELL NO: TW-K4
 DATE INSTALLED: 3-6-88
 DRILLER: Luisier Drilling, Inc.
 DRILLING METHOD: Mud rotary, air

CLIENT: Kenecott
 PROJECT: Rock permeability
 SCOPE I.D.: 87K10-W.O. 66
 BY: BJS

LOG OF TEST BORING NO.: TW - K4 (PZ - K4P, PZ - K4PP)


SURFACE ELEVATION: 1140.1 Feet

BORING DEPTH: 193.0 Feet

DATE: 03-06-88

CLIENT: Kenecott
 PROJECT: Rock Permeability
 PROJECT NUMBER: 87K10 - W066
 LOCATION: NE end of pit, near PZ - S4
 COORDINATES: N41,204.15, E40,662.92

MSL ELEV	DEPTH FR LND SURF	SAMP DEPTH INTERVAL	TYPE	#	N	REC (ft)	DESCRIPTION OF MATERIAL	CLASS	LABORATORY TESTS	DRILLING AND SAMPLING NOTES
1140.1	--0						Drilled wo/sampling to 52' Cuttings brn sand and grl, to 15' red brn SILTY SAND (till) to about 30'.	SP, GP,		
1120.1	--20						At about 30' v.fn. silty sandstone w/shale layers to 47', then yel. brn., SILT, soft.	SM		
1100.1	--40							SM (ss)		
		52'-63'		*g				ML		
1080.1	--60	63'-73'		g			Cuttings to 103', red brn., hematitic, moist. Interbedded biotite schist and metadacite			
		73'-83'		g						
1060.1	--80	83'-93'		g				PC (2c)		
		93'-103'		g				(5)		
1040.1	--100	103'-113'		g			At 113' red brn, hematitic, w/fn grl. size chips, wet, clayey.			
		113'-123'		g						
1020.1	--120	123'-133'		g			Water at about 123', 2-3gpm metadacite.			
		133'-143'		g				(5)		
1000.1	--140	143'-153'		g						
		153'-163'		g						
980.1	--160	163'-173'		g						
		173'-183'		g						
960.1	--180	183'-193'					EOB at 193' in metadacite.			
940.1	--200									*g=grab samples of cuttings.
920.1	--220									

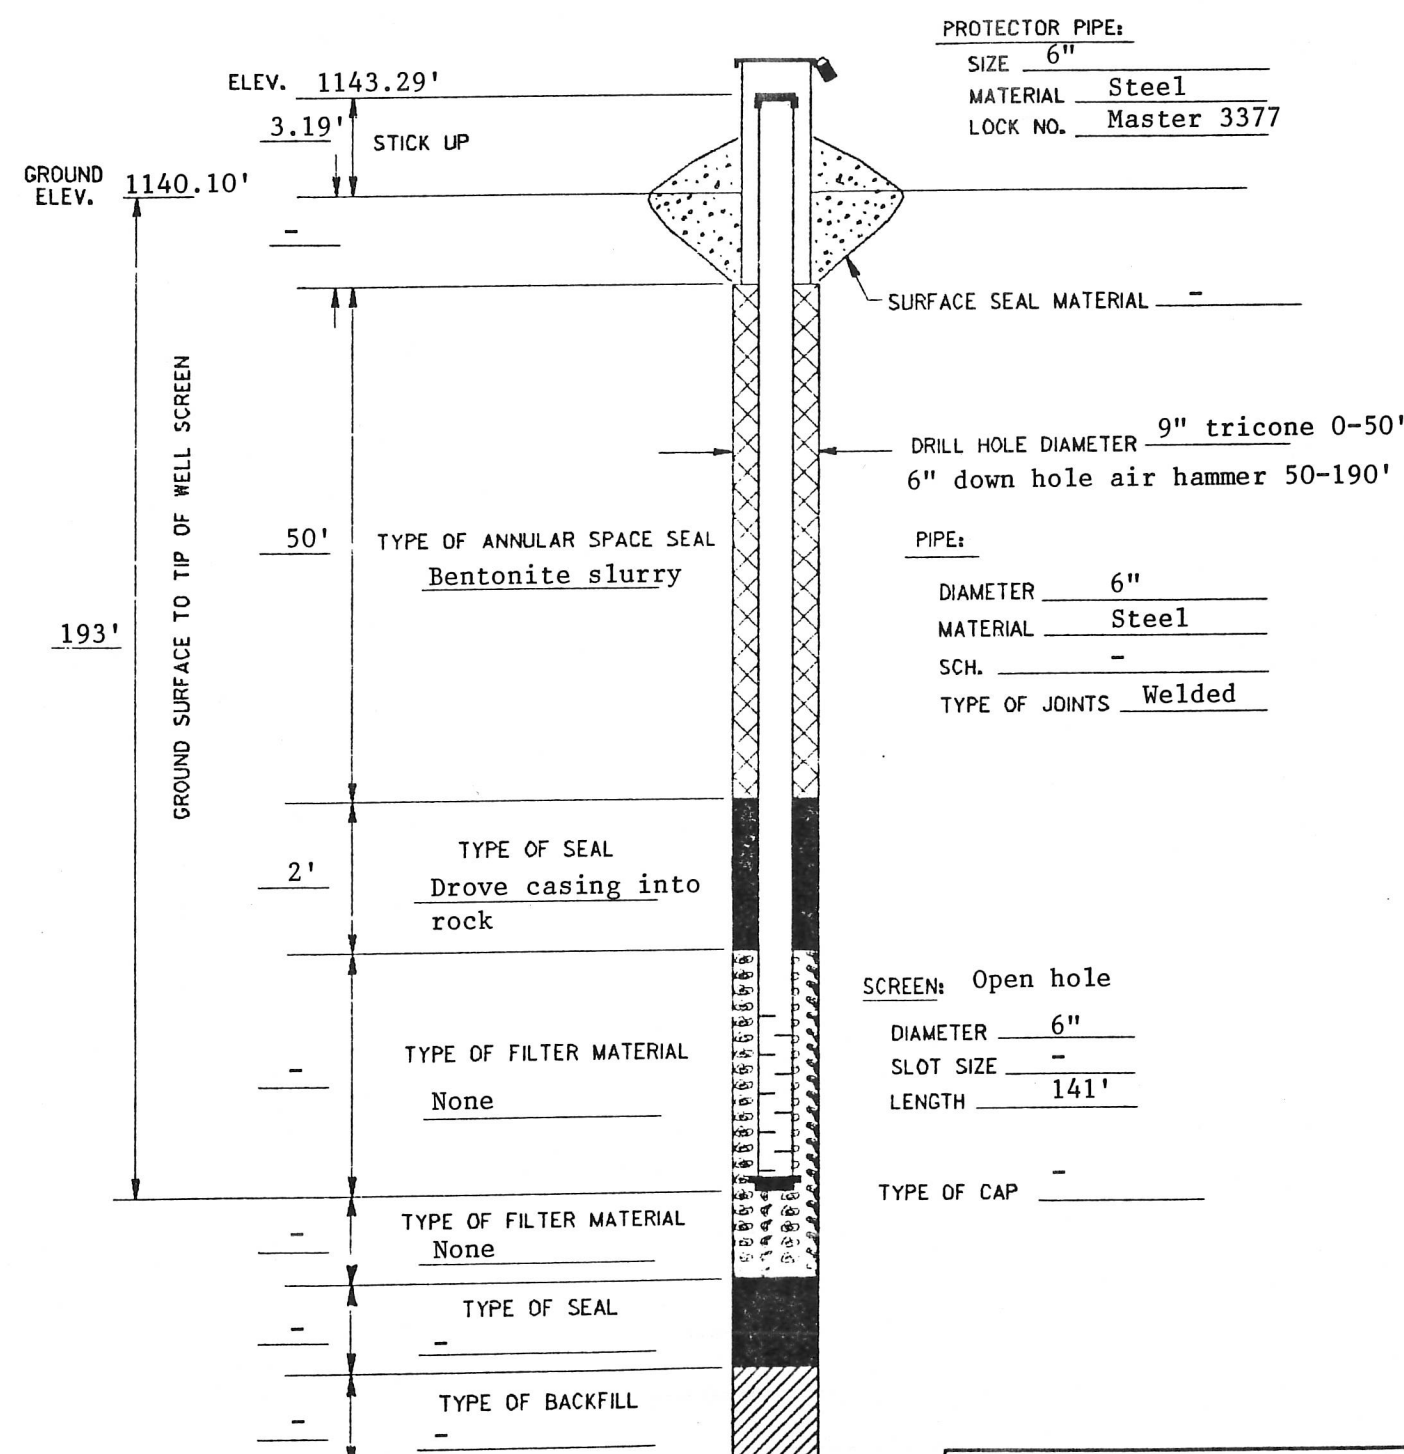

DRILLING DATA	WATER LEVEL INFORMATION
START DATE: 03/06/88 7:30AM	DEPTH AT COMPLETION: 110 Feet
COMPLETION DATE: 03/06/88 12:30PM	LATER TIME/DEPTH: 1:45PM/35'
LOGGED BY: BJS	LATER TIME/DEPTH: 5:15PM/27.4'
DRILLING METHOD: Mud rotary to 50'; air 193'.	CAVE IN DEPTH:
DRILLING CONTRACTOR: Luisier Drilling, Inc.	DRILLING LOSSES:

Foth & Van Dyke
 Geosciences & Environmental
 Management Division
 Revised 3/88 By BJS
 Drawn By MRS

MONITORING WELL DEVELOPMENT

WELL NUMBER TW-K4 CLIENT Kennecott
 WELL DIAMETER 6" PROJECT Rock permeability
 TOTAL DEPTH OF WELL 193' SCOPE I.D. 87K10-W.O. 66
 DEPTH TO WATER _____ TIME OF MEASUREMENT BY BJS
 BEFORE - 11:50 a.m. DATE 3-6-88
 AFTER 110' 12:45 p.m.

DESCRIPTION OF DEVELOPMENT METHOD

Well completed at 11:50 a.m. on 3-6-88; blew out 3-4 gpm for 30 min.

VOLUME OF WATER REMOVED FROM WELL Approx. 110 gals.
 CLARITY OF WATER IN WELL BEFORE DEVELOPMENT Red brn., silty
 CLARITY OF WATER IN WELL AFTER DEVELOPMENT Lt. red brn., silty
 PRESENCE OF SEDIMENT AT THE BOTTOM OF THE WELL Silt
 VOLUME OF WATER ADDED TO WELL None
 SOURCE OF WATER ADDED TO WELL -
 TIME SPENT FOR DEVELOPMENT 0.7 hrs.

STABILIZATION READINGS

GAL. REMOVED	TIME	FIELD		
		TEMPERATURE	SPEC. COND.	pH
_____	_____	_____	_____	_____
_____	_____	_____	_____	_____
FOTH AND VAN DYKE

LOG OF TEST BORING NO.: TW - K5, TW - K5R							SURFACE ELEVATION: 1102.3 Feet			
CLIENT: Kennecott PROJECT: Rock Permeability PROJECT NUMBER: 87K10 - W066 LOCATION: River pillar, about 40' SW of baseline. COORDINATES: N41490.04, E40444.96 (TW-K5R)							BORING DEPTH: 193.0 Feet			
							DATE: 03-05-88			
MSL ELEV	DEPTH FR LND SURF	SAMP DEPTH INTERVAL	TYPE	#	N	REC (ft)	DESCRIPTION OF MATERIAL	CLASS	LABORATORY TESTS	DRILLING AND SAMPLING NOTES
1102.3	--0						Drilled w/sampling to 55' Silt to about 10', then silty sand till to about 30'	ML		
1082.3	--20						At about 30', cse & med. qtz sand (sandstone).	SM		
1062.3	--40	55'-63'	*g				At about 47' yel. brn. extremely altered schist (silt).	SP (ss)		
1042.3	--60	63'-73'	g				Cuttings mostly lt. blue gray powder (biotite, chlorite, quartz, sericite schist.)	"ML"		
1022.3	--80	73'-83'	g				Cuttings from 80' to about 100' w/grl size pieces, chert, hard w/pyrite in schist.	PC (2b)		
		83'-93'	g							
1002.3	--100	93'-103'	g				Cuttings to bottom of hole, mostly powder.			
		103'-113'	g							
982.3	--120	113'-123'	g							
		123'-133'	g							
962.3	--140	133'-143'	g							
		143'-153'	g							
942.3	--160	153'-163'	g							
		163'-173'	g							
922.3	--180	173'-183'	g							
		183'-193'	g							
902.3	--200						EOB at 193' in biotite schist.			*g=grab samples of cuttings.
882.3	--220									

DRILLING DATA	WATER LEVEL INFORMATION
START DATE: 03/05/88 2:30PM	DEPTH AT COMPLETION: DRY
COMPLETION DATE: 03/05/88 5:30PM	LATER TIME/DEPTH: 7:30AM/3-6/90'
LOGGED BY: BJS	LATER TIME/DEPTH: 7:30AM/3-7/36'
DRILLING METHOD: Mud rotary to 55'; air to 193'.	CAVE IN DEPTH: 56'
DRILLING CONTRACTOR: Luisier Drilling, Inc.	DRILLING LOSSES:

MONITORING WELL CONSTRUCTION DIAGRAM

WELL NO: TW-K5
 DATE INSTALLED: 3-5-88
 DRILLER: Luisier Drilling, Inc.
 DRILLING METHOD: Mud rotary, air

CLIENT: Kennecott
 PROJECT: Rock permeability
 SCOPE I.D.: 87K10-W.O. 66
 BY: BJS

PROTECTOR PIPE:
 SIZE 6"
 MATERIAL Steel
 LOCK NO. Master 3377


DRILL HOLE DIAMETER 9" tricone 0-55'
6" down hole air hammer 55-193'

PIPE:
 DIAMETER 6"
 MATERIAL Steel
 SCH. -
 TYPE OF JOINTS Welded

SCREEN: Open hole

DIAMETER 6"
 SLOT SIZE -
 LENGTH 136'

TYPE OF CAP -

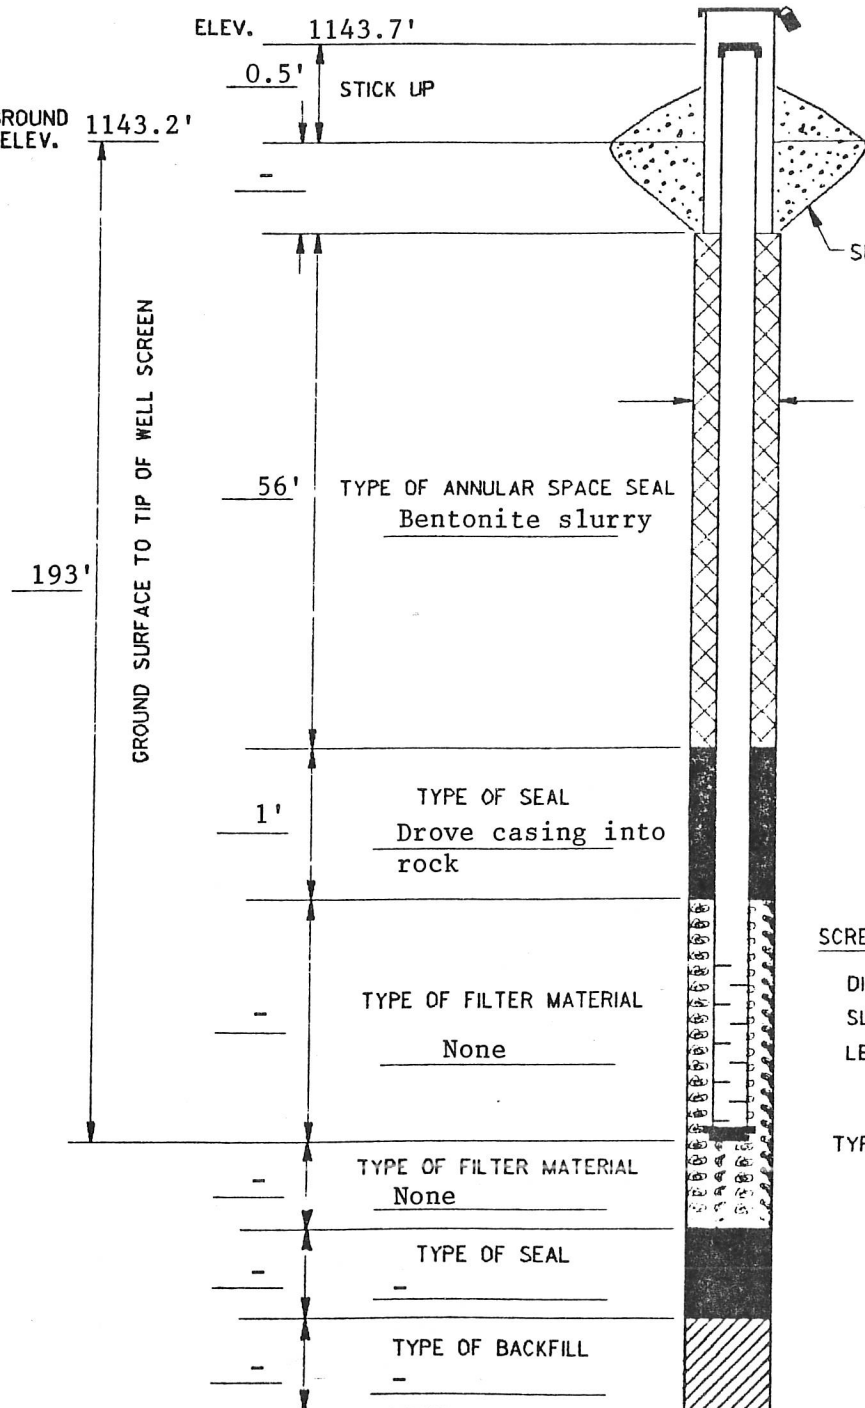

Foth & Van Dyke

Geosciences & Environmental
 Management Division
 Revised 3/88 By BJS
 Drawn By MRS

MONITORING WELL DEVELOPMENT

WELL NUMBER TW-K5 CLIENT Kennecott
 WELL DIAMETER 6" PROJECT Rock permeability
 TOTAL DEPTH OF WELL 193' SCOPE I.D. 87K10-W.O. 66
 DEPTH TO WATER - TIME OF MEASUREMENT BY BJS
 BEFORE 90' 7:30 a.m. DATE 3-6-88
 AFTER Dry 8:00 a.m.

DESCRIPTION OF DEVELOPMENT METHOD

Well was dry on completion at 5:15 p.m. on 3-5-88.
 Well was blown out with air on 3-6-88.
 Well caved to bottom of steel casing before it could be developed with cable tool rock bailer on 3-9-88.

VOLUME OF WATER REMOVED FROM WELL Approx. 145 gals.
 CLARITY OF WATER IN WELL BEFORE DEVELOPMENT Lt. gray silty
 CLARITY OF WATER IN WELL AFTER DEVELOPMENT Lt. gray silty
 PRESENCE OF SEDIMENT AT THE BOTTOM OF THE WELL Silt
 VOLUME OF WATER ADDED TO WELL None
 SOURCE OF WATER ADDED TO WELL -
 TIME SPENT FOR DEVELOPMENT 0.5 hrs.

STABILIZATION READINGS

GAL. REMOVED	TIME	FIELD		
		TEMPERATURE	SPEC. COND.	pH
_____	_____	_____	_____	_____
_____	_____	_____	_____	_____
FOTH AND VAN DYKE

MONITORING WELL CONSTRUCTION DIAGRAM

WELL NO: TW-K5R CLIENT: Kennecott
 DATE INSTALLED: 3-26-88 PROJECT: Rock permeability
 DRILLER: Luisier Drilling, Inc. SCOPE I.D.: 87K10-W.O. 66
 DRILLING METHOD: Mud rotary, air BY: BJS


PROTECTOR PIPE:
 SIZE 6"
 MATERIAL Steel
 LOCK NO. Master 3377

Outer PIPE:
 DIAMETER 6"
 MATERIAL Steel
 SCH. -
 TYPE OF JOINTS Welded

Inner Pipe:
 Diameter 4"
 Material PVC
 Sch. 40
 Type of joints Flush threaded

SCREEN:
 DIAMETER 4"
 SLOT SIZE 40
 LENGTH 108' (alternating 10' lengths of screen and pipe)

TYPE OF CAP PVC

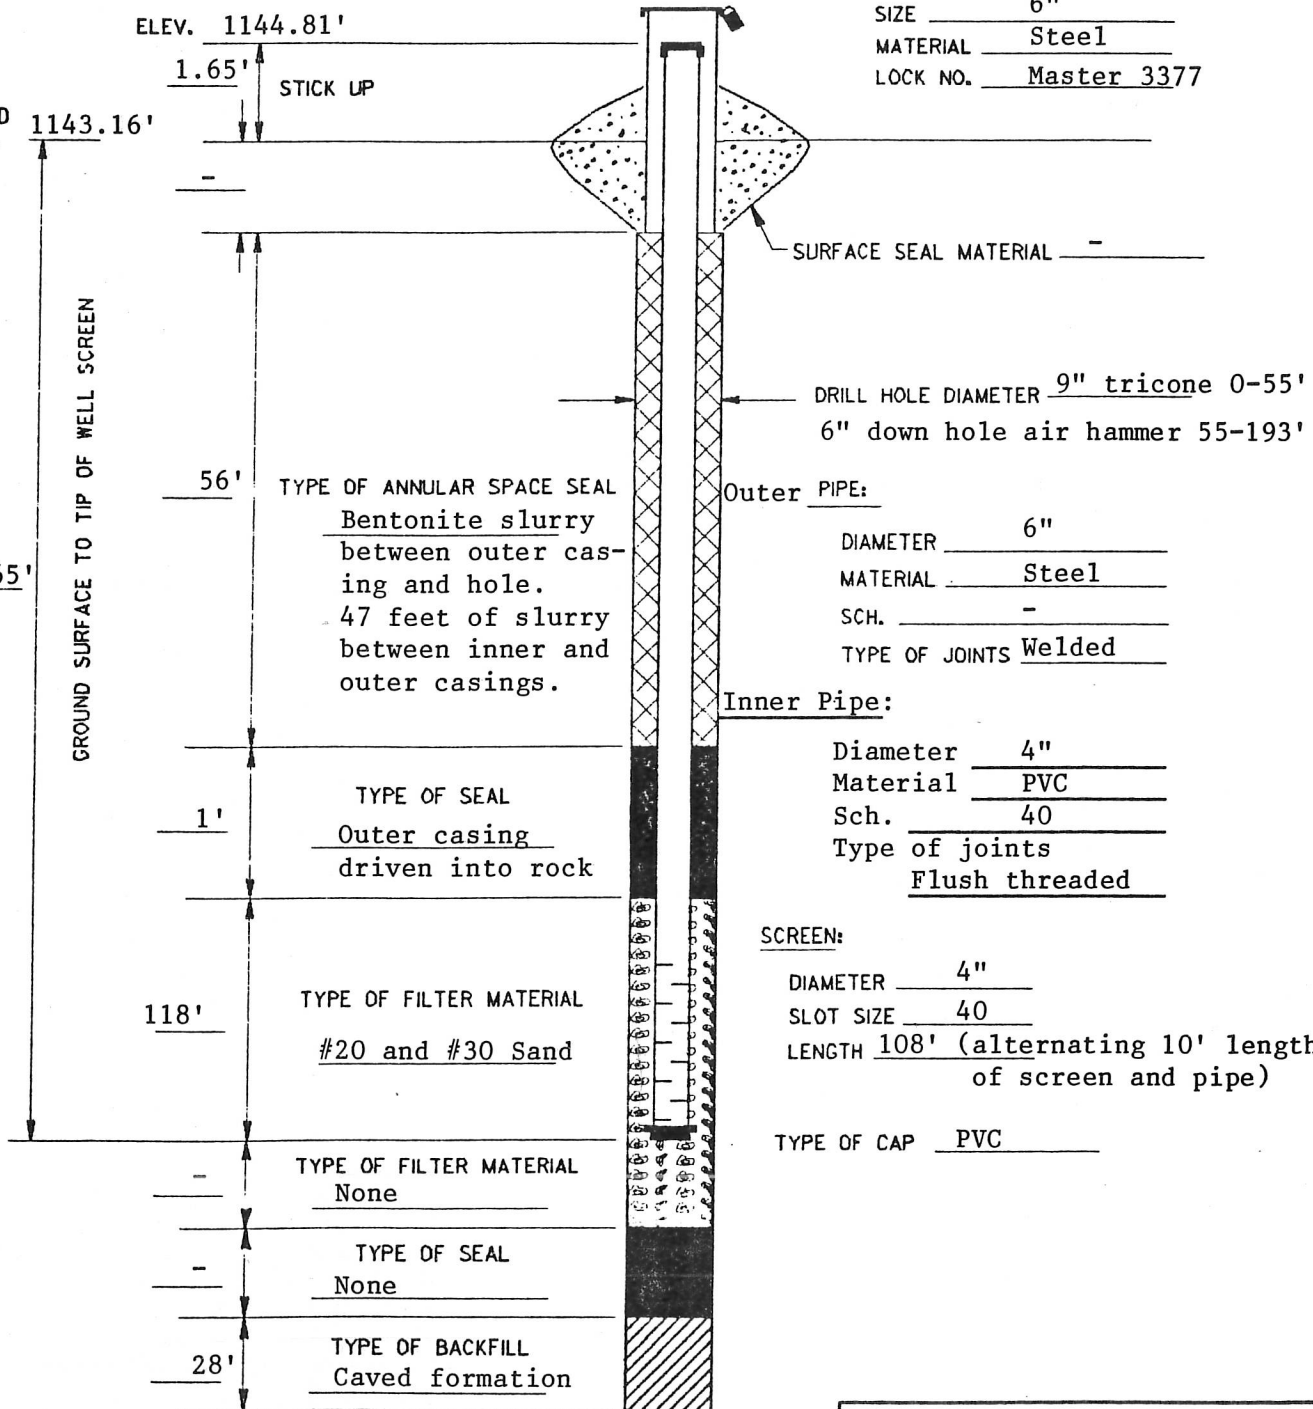

Note: TW-K5R was installed in open hole well TW-K5. Hole had caved to 56 feet and was redrilled to 193 feet.

Foth & Van Dyke
 Geosciences & Environmental
 Management Division
 Revised 3/88 By BJS
 Drawn By MRS

MONITORING WELL DEVELOPMENT

WELL NUMBER TW-K5R CLIENT Kennecott
 WELL DIAMETER 4" PROJECT Rock permeability
 TOTAL DEPTH OF WELL 165' SCOPE I.D. 87K10-W.O. 66
 DEPTH TO WATER _____ TIME OF MEASUREMENT _____ BY BJS
 BEFORE _____ - _____ DATE 3-26-88
 AFTER _____ - _____

DESCRIPTION OF DEVELOPMENT METHOD

At completion of drilling, blew out 2 to 3 gpm from open hole from 11:54 a.m. to 12:02 p.m.
 Set A-rod in the 4" PVC well and surged with air for 5 min.
 Blew out about 2 gpm from 4:24 to 4:29 p.m.

VOLUME OF WATER REMOVED FROM WELL Approx. 30 gals. (total)
 CLARITY OF WATER IN WELL BEFORE DEVELOPMENT Lt. gray, silty
 CLARITY OF WATER IN WELL AFTER DEVELOPMENT Lt. gray, silty
 PRESENCE OF SEDIMENT AT THE BOTTOM OF THE WELL Silt
 VOLUME OF WATER ADDED TO WELL None
 SOURCE OF WATER ADDED TO WELL -
 TIME SPENT FOR DEVELOPMENT 0.5 hrs.

STABILIZATION READINGS

GAL. REMOVED	TIME	FIELD		
		TEMPERATURE	SPEC. COND.	pH
_____	_____	_____	_____	_____
_____	_____	_____	_____	_____
FOTH AND VAN DYKE


LOG OF TEST BORING NO.: TW - K6, TW - K6R							SURFACE ELEVATION: 1118.2 Feet			
CLIENT: Kennecott PROJECT: Rock Permeability PROJECT NUMBER: 87K10 - W066 LOCATION: Center of pit, west side. COORDINATES: N40,397.05, E39,248.53 (TW - K6R)							BORING DEPTH: 183.0 Feet			
							DATE: 03-07-88			
MSL ELEV	DEPTH FR LND SURF	SAMP DEPTH INTERVAL	TYPE	#	N	REC (ft)	DESCRIPTION OF MATERIAL	CLASS	LABORATORY TESTS	DRILLING AND SAMPLING NOTES
1118.2	--0						Drilled w/sampling to 43' Cuttings sand and grl, and silty sand (till).	SP, GP, SM		
1098.2	--20						Sandstone.	SS		
1078.2	--40	43'-53'	*g				Cuttings red brn and purple red, v. soft, sticky, drill w/foam.			
		53'-63'	g							
1058.2	--60	63'-73'	g				Altered schist. (Metadacite)			
1038.2	--80	73'-83'	g					PC		
		83'-93'	g					(5)		
1018.2	--100	93'-103'	g							
		103'-113'	g							
998.2	--120	113'-123'	g							
		123'-133'	g							
978.2	--140	133'-143'	g							
		143'-153'	g							
958.2	--160	153'-163'	g							
		163'-173'	g							
938.2	--180	173'-183'	g				EOB at 183' in altered schist. (Metadacite)			

*g=grab samples of cuttings.

DRILLING DATA	WATER LEVEL INFORMATION
START DATE: 03/07/88 7:00AM	DEPTH AT COMPLETION: DRY
COMPLETION DATE: 03/07/88 11:30AM	LATER TIME/DEPTH:
LOGGED BY: BJS	LATER TIME/DEPTH:
DRILLING METHOD: Mud rotary to 43'; air w/foam to 183'.	CAVE IN DEPTH:
DRILLING CONTRACTOR: Luisier Drilling, Inc.	DRILLING LOSSES:

MONITORING WELL CONSTRUCTION DIAGRAM

WELL NO: TW-K6 (Abandoned) CLIENT: Kennecott
 DATE INSTALLED: 3-7-88 PROJECT: Rock permeability
 DRILLER: Luisier Drilling, Inc. SCOPE I.D.: 87K10-W.O. 66
 DRILLING METHOD: Mud rotary, air BY: BJS

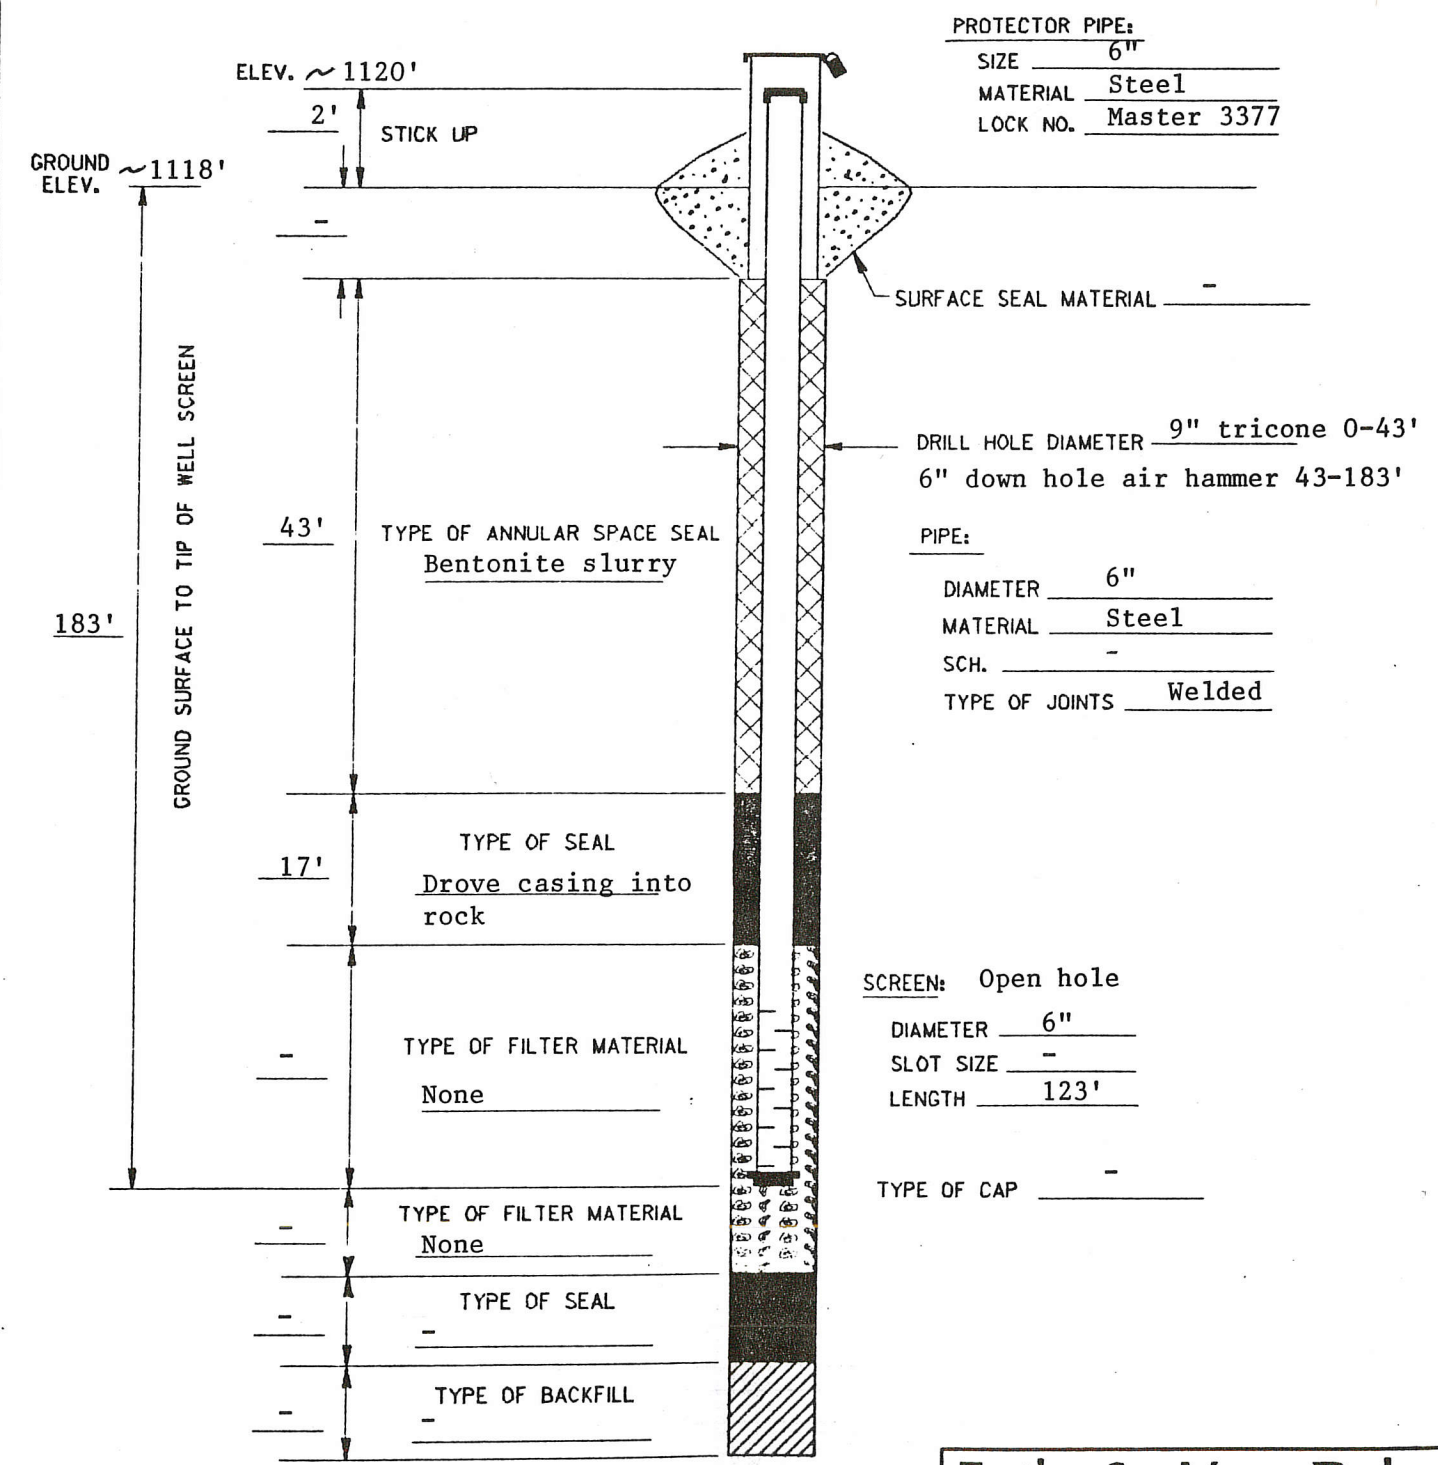

Foth & Van Dyke
 Geosciences & Environmental
 Management Division
 Revised 3/88 By BJS
 Drawn By MRS

MONITORING WELL DEVELOPMENT

WELL NUMBER TW-K6 CLIENT Kennecott
 WELL DIAMETER 6" PROJECT Rock permeability
 TOTAL DEPTH OF WELL 183' SCOPE I.D. 87K10-W.O. 66
 DEPTH TO WATER TIME OF MEASUREMENT BY BJS
 BEFORE - 11:15 a.m. DATE 3-7-88
 AFTER 179.4' 12:45 p.m.

DESCRIPTION OF DEVELOPMENT METHOD

At 11:15 a.m. on completion, blew out well with air. Blew out approximately 0.3 gpm for 10 min. Well caved to the bottom of the steel casing before it could be developed with cable tool rock bailer on 3-9-88.

VOLUME OF WATER REMOVED FROM WELL Approx. 3 gals.
 CLARITY OF WATER IN WELL BEFORE DEVELOPMENT Red brn., silty
 CLARITY OF WATER IN WELL AFTER DEVELOPMENT Red brn., silty
 PRESENCE OF SEDIMENT AT THE BOTTOM OF THE WELL Silt
 VOLUME OF WATER ADDED TO WELL None
 SOURCE OF WATER ADDED TO WELL -
 TIME SPENT FOR DEVELOPMENT 0.5 hrs.

STABILIZATION READINGS

GAL. REMOVED	TIME	FIELD		
		TEMPERATURE	SPEC. COND.	pH

FOTH AND VAN DYKE

(1) GENERAL INFORMATION		(2) FACILITY NAME	
Well/Drillhole Location	County	Original Well Owner (If Known)	
	Rusk	Kennecott	
SW 1/4 of SE 1/4 of Sec. 9; T. 34 N; R. 6		Present Well Owner	
(If applicable)		Same	
Gov't Lot		Street or Route	
-		1515 Mineral Square	
Civil Town Name		City, State, Zip Code	
Grant		Salt Lake City, UT 84112	
Street Address of Well		Well Number and/or Name (If Applicable)	
-		TW-K6	
City, Village		Reason For Abandonment	
Ladysmith		Well was caved from 183 to 60 feet	
Date of Abandonment			
3-24-88			

WELL/DRILLHOLE INFORMATION	
(3) Original Well/Drillhole Construction Completed on (Date) <u>3-7-88</u>	
<input checked="" type="checkbox"/> Water Well <input type="checkbox"/> Drillhole Construction Type: <input checked="" type="checkbox"/> Drilled <input type="checkbox"/> Driven (Sandpoint) <input type="checkbox"/> Dug <input type="checkbox"/> Other (Specify) _____	Construction Report Available? <input checked="" type="checkbox"/> Yes <input type="checkbox"/> No
Well Type: <input type="checkbox"/> Unconsolidated Formation Well <input checked="" type="checkbox"/> Bedrock Well	(4) Depth to Water (Feet) <u>9</u> Pump & Piping Removed? <input type="checkbox"/> Yes <input type="checkbox"/> No <input checked="" type="checkbox"/> Not Applicable Liner(s) Removed? <input type="checkbox"/> Yes <input type="checkbox"/> No <input checked="" type="checkbox"/> Not Applicable Screen Removed? <input type="checkbox"/> Yes <input type="checkbox"/> No <input checked="" type="checkbox"/> Not Applicable Casing Left in Place? <input checked="" type="checkbox"/> Yes <input type="checkbox"/> No If No, Explain _____ Was Casing Cut Off Below Surface? <input checked="" type="checkbox"/> Yes <input type="checkbox"/> No Did Sealing Material Rise to Surface? <input checked="" type="checkbox"/> Yes <input type="checkbox"/> No Did Material Settle After 24 Hours? <input type="checkbox"/> Yes <input checked="" type="checkbox"/> No If Yes, Was Drillhole Retopped? <input type="checkbox"/> Yes <input type="checkbox"/> No
Total Well Depth (ft.) <u>183'</u> Casing Diameter (ins.) <u>6"</u>	(5) Required Method of Placing Sealing Material <input checked="" type="checkbox"/> Conductor Pipe-Gravity <input type="checkbox"/> Conductor Pipe-Pumped <input type="checkbox"/> Dump Bailer <input type="checkbox"/> Other (Explain) _____
Casing Depth (ft.) <u>60'</u>	(6) Acceptable Sealing Materials Neat Cement Grout; Concrete Grout; Concrete; Clay Slurry; (Sodium Bentonite Slurry)
Was Well Annular Space Grouted? <input checked="" type="checkbox"/> Yes <input type="checkbox"/> No <input type="checkbox"/> Unknown If Yes, To What Depth? <u>43</u> Feet	

(7) Kind of Sealing Material	From (Ft.)	To (Ft.)	No. Yards or Sacks Sealant	Mix Ratio or Mud Weight
Clayey cuttings	Surface	2'	-	-
Bentonite slurry	2	60'	1 bag	Approx. 50 lbs./50 gals.

(8) Comments:


(9) Name of Person or Firm Doing Sealing Work		(10) FOR DNR OR COUNTY USE ONLY	
Luisier Drilling, Inc.		Date Received/Inspected	District/County
Signature of Person Doing Work	Date Signed		
Keith Meyers			
Street or Route	Telephone Number	Reviewer/Inspector	
7391 Porcupine Lake Rd.	(414) 829-5239		
City, State, Zip Code		Follow-up Necessary	
Lena, WI 54139			

MONITORING WELL CONSTRUCTION DIAGRAM

WELL NO: TW-K6R
 DATE INSTALLED: 3-24-88
 DRILLER: Luisier Drilling, Inc.
 DRILLING METHOD: Mud rotary, air

CLIENT: Kennecott
 PROJECT: Rock permeability
 SCOPE I.D.: 87K10-W.O. 66
 BY: BJS

PROTECTOR PIPE:
 SIZE 6"
 MATERIAL Steel
 LOCK NO. Master 3377

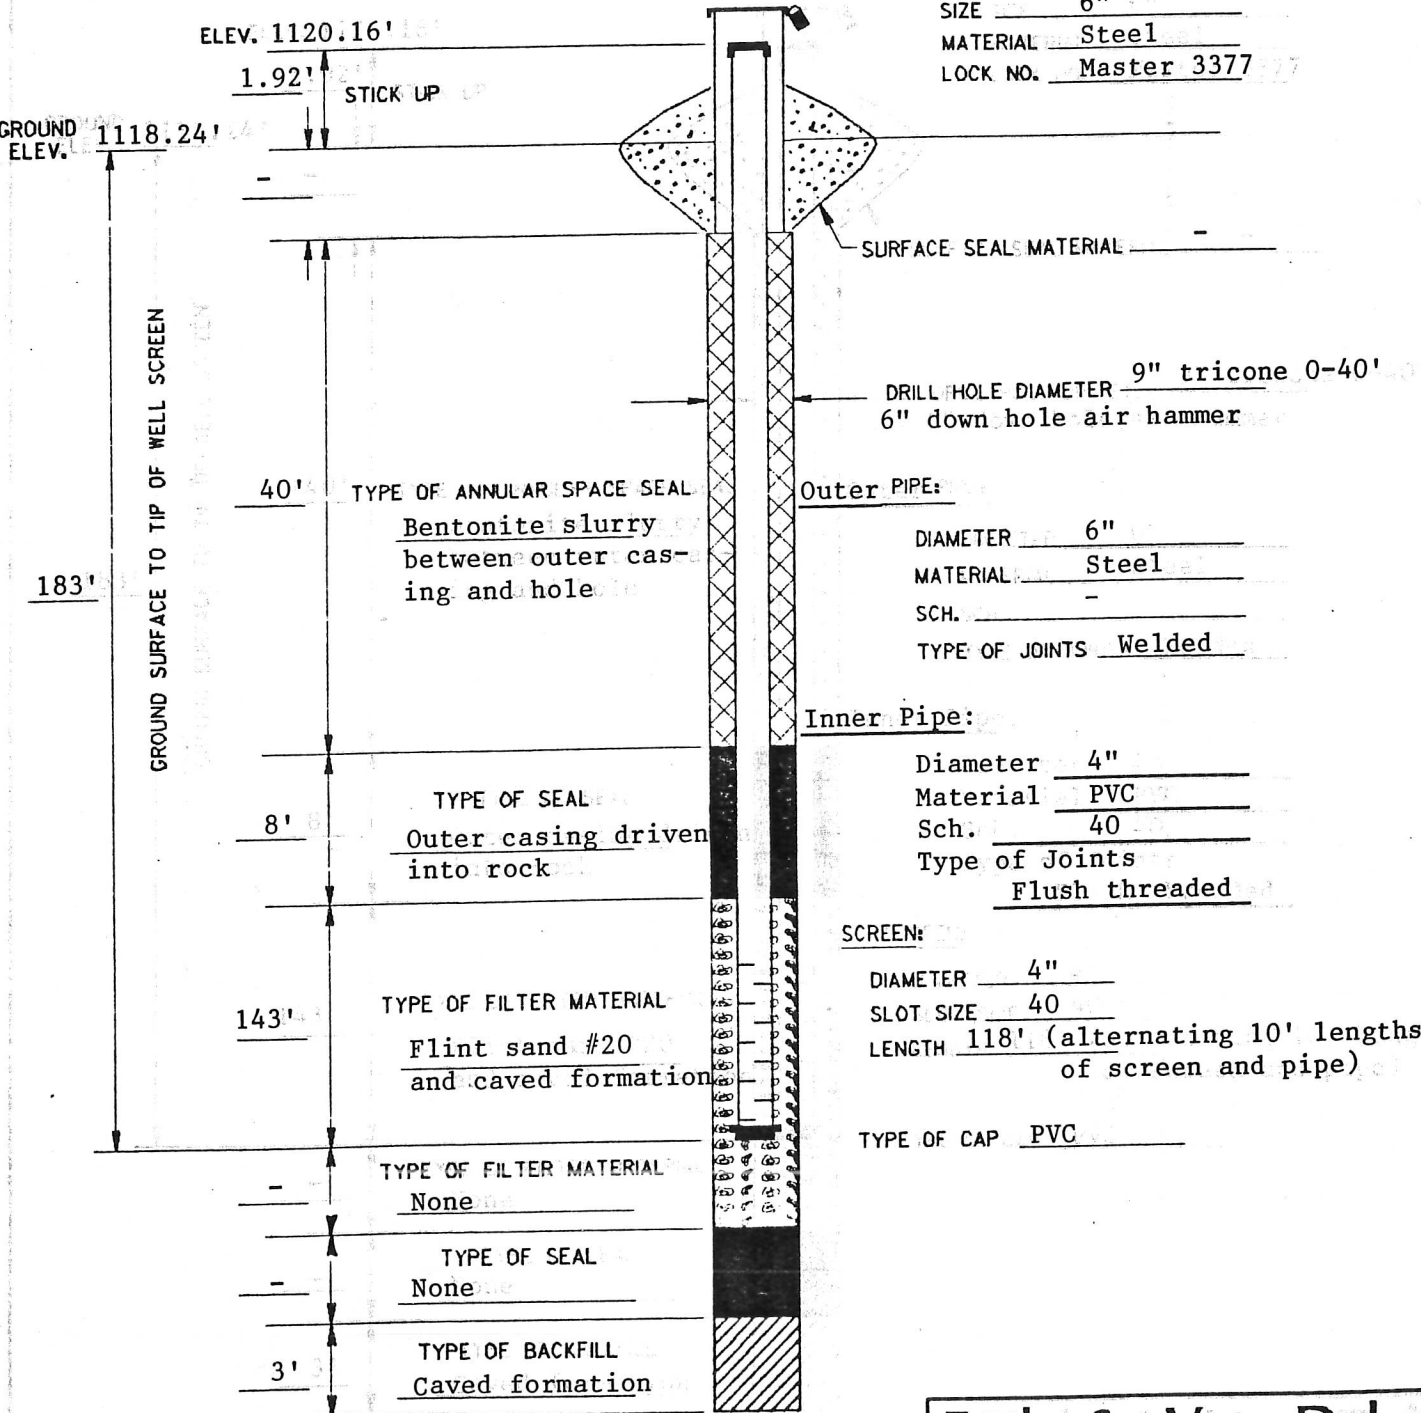

Note: TW-K6R was drilled about 15' south of TW-K6. TW-K6 caved to 60 ft.

Foth & Van Dyke
 Geosciences & Environmental Management Division
 Revised 3/88 By BJS
 Drawn By MRS

MONITORING WELL DEVELOPMENT

WELL NUMBER TW-K6R CLIENT Kennecott
 WELL DIAMETER 4" PROJECT Rock permeability
 TOTAL DEPTH OF WELL 183' SCOPE I.D. 87K10-W.O. 66
 DEPTH TO WATER BEFORE 13.5' TIME OF MEASUREMENT 8:30 a.m. BY BJS
 AFTER 175.7' 9:10 a.m. DATE 3-25-88

DESCRIPTION OF DEVELOPMENT METHOD

Set 57 ft. of A-rod in the 4" PVC well and surged with air for 10 min. Filled well with water twice. Blew out dry.

VOLUME OF WATER REMOVED FROM WELL 250 gals.
 CLARITY OF WATER IN WELL BEFORE DEVELOPMENT Red brn., silty
 CLARITY OF WATER IN WELL AFTER DEVELOPMENT Red brn., silty
 PRESENCE OF SEDIMENT AT THE BOTTOM OF THE WELL Silt
 VOLUME OF WATER ADDED TO WELL 400 gals.
 SOURCE OF WATER ADDED TO WELL On-site water supply well
 TIME SPENT FOR DEVELOPMENT 1 hr.

STABILIZATION READINGS

GAL. REMOVED	TIME	TEMPERATURE	FIELD	
			SPEC. COND.	pH
_____	_____	_____	_____	_____
_____	_____	_____	_____	_____
_____	_____	_____	_____	_____
_____	_____	_____	_____	_____


FOTH AND VAN DYKE

LOG OF TEST BORING NO.: TW-K7							SURFACE ELEVATION: 1098.18			
CLIENT: Kennecott PROJECT: Pit Inflow PROJECT NUMBER: 87K10 LOCATION: River Pillar COORDINATES: 39896.18 N 38813.28 E							BORING DEPTH: 31'			
							DATE: 09/20/88			
MSL ELEV	DEPTH FR LND SURF	SAMP DEPTH INTERVAL	TYPE	#	N Sec	REC (ft)	DESCRIPTION OF MATERIAL	CLASS	LABORATORY TESTS	DRILLING AND SAMPLING NOTES
1098.2	--0	1-3	SB	1	P	2.0	Brown poorly graded SAND, fine, loose w/ roots & organics, dry, (very fine aeolian sand), boulders at 3 feet	SP		
1093.2	--5	5-7	SB	2	P	1.5	5-5.5 Lt. brown poorly graded SAND fine with coarse gravel (cobble). 5.5-6 Red brown silty SAND, fine, diamict. 6-6.5 Red brown well graded gravel, fine to coarse w/red brown silty SAND	SP, SM, GW		
1088.2	--10	10-12	SB	3	P	0.5	Well graded GRAVEL, cored granite			
		11-13	SB	4	20	2.0	Red brown (5YR 4/3) silty GRAVEL, well graded, coarse w/fine w/fine to coarse sand, well rounded gravel. Few 1" thick SP layers, much gravel, boulders to 15'	GM		
1083.2	--15	16-18	SB	5	20	2.0	Red brown (5YR 4/3) poorly graded SAND, fine, laminated, saturated	SP		
1078.2	--20	20-22	SB	6	20	0.5	Black (10YR 2/1) well graded GRAVEL w/ silt, coarse with fine, stained with few brown yellow mottles (10YR 6/8), dense, little sand	GW-GM	Pump Test Permeability: K=5.4 x 10E-3 cm/sec K=4.3 x 10E-3 cm/sec (recovery)	Many cobbles, boulders, 20-30 feet.
1073.2	--25	25-27	SB	7	80	1.0	Same as above except yellow brown with little black mottling			
1068.2	--30	30-32	SB	8	85	1.3	Top 0.3' gravel as above, dark red brown (2.5YR 2.5/4) and yellow brown (10YR 5/6) SILT, color laminated, soft, brittle (altered schist) w/ broken very hard chert layers	ML (2a)		
1063.2	--35						31.0'-End of Boring			
1058.2	--40									
1053.2	--45									
1048.2	--50									
1043.2	--55									

DRILLING DATA	WATER LEVEL INFORMATION
START DATE: 09/20/88	DEPTH AT COMPLETION:
COMPLETION DATE: 09/20/88	LATER TIME/DEPTH:
LOGGED BY: BJS	LATER TIME/DEPTH:
DRILLING METHOD: Air to 10 feet, mud rotary to 31 feet, 6" bit	CAVE IN DEPTH:
DRILLING CONTRACTOR: Luisier Well Drilling, Inc.	DRILLING LOSSES:

MONITORING WELL CONSTRUCTION DIAGRAM

WELL NO: TW-K7 CLIENT: Kennecott
 DATE INSTALLED: 9-21-88 PROJECT: Pit Inflow
 DRILLER: Luisier Drilling, Inc. SCOPE I.D.: 87K1088
 DRILLING METHOD: Air/Mud Rotary BY: BJS
 COORDINATES: 39912.28N 38, 811.98E

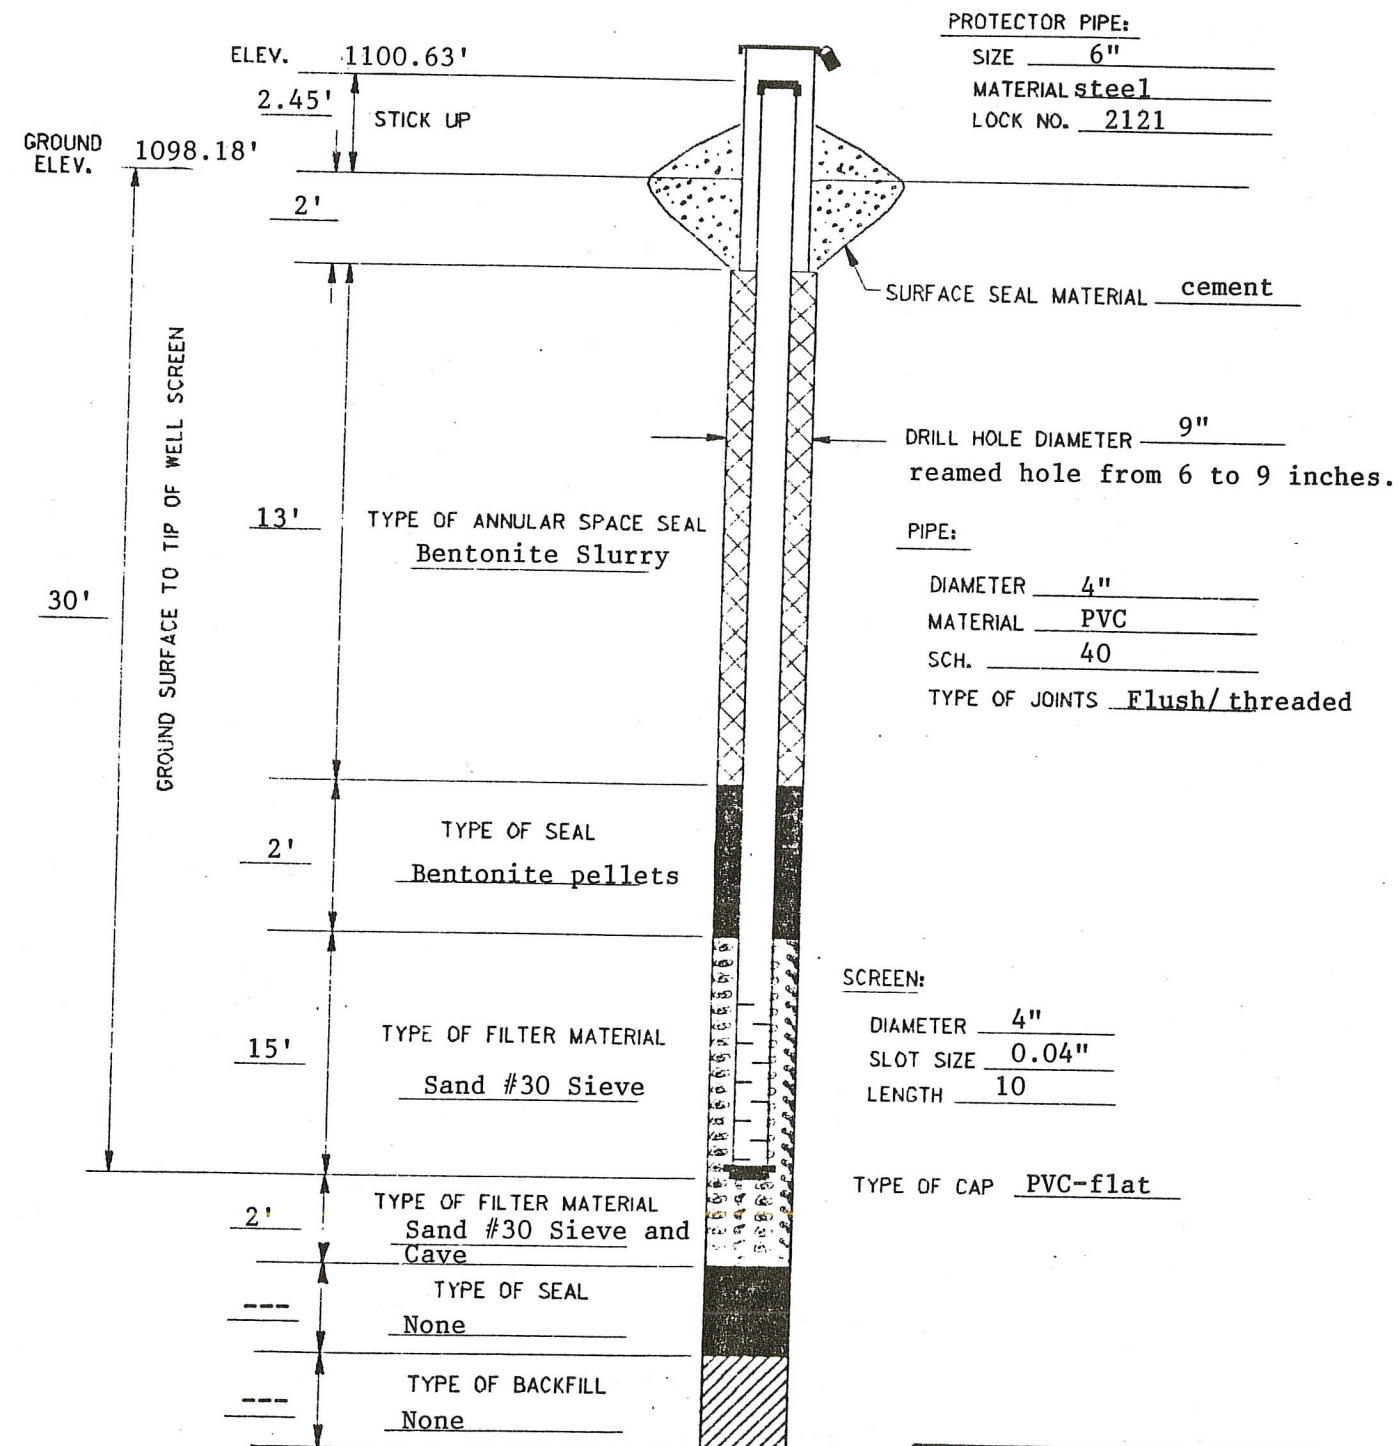

Foth & Van Dyke
 Geosciences & Environmental
 Management Division
 Revised 3/88 By BJS
 Drawn By MRS

MONITORING WELL DEVELOPMENT

WELL NUMBER TW-K7 CLIENT Kennecott
 WELL DIAMETER 4" PROJECT Pit Inflow
 TOTAL DEPTH OF WELL 30' SCOPE I.D. 87K10
 DEPTH TO WATER _____ TIME OF MEASUREMENT _____ BY BJS
 BEFORE --- _____ DATE 9-21-88
 AFTER --- _____

DESCRIPTION OF DEVELOPMENT METHOD

Surged with air from 11:39 to 11:42 a.m. Blew out about 4 gpm from 11:42 to 11:52 a.m. Jetted moving drill rod up and down in well from 11:52 to 11:55 a.m. Produced v. dk red brn silty water. Blew out about 7 gpm from 11:55 to 12:06 p.m. Surged at 12:06 p.m. Continued to blow out to 12:25 p.m. Surged at 12:26 p.m. Water dk brn, v. silty. Continued to blow out about 7 gpm. Jetted at 12:40 p.m. Surged at 12:53 p.m. Blew out 1:22 p.m. Water clear, v. pale brn.

VOLUME OF WATER REMOVED FROM WELL 200 gallons
 CLARITY OF WATER IN WELL BEFORE DEVELOPMENT V. dark red brn, silty
 CLARITY OF WATER IN WELL AFTER DEVELOPMENT V. pale brown
 PRESENCE OF SEDIMENT AT THE BOTTOM OF THE WELL slightly silty
 VOLUME OF WATER ADDED TO WELL none
 SOURCE OF WATER ADDED TO WELL ---
 TIME SPENT FOR DEVELOPMENT 45 Minutes

STABILIZATION READINGS

GAL. REMOVED	TIME	FIELD		
		TEMPERATURE	SPEC. COND.	pH
_____	_____	_____	_____	_____
_____	_____	_____	_____	_____
FOTH AND VAN DYKE

LOG OF TEST BORING NO.: PZ-KB

CLIENT: Kennecott
 PROJECT: Pit Inflow
 PROJECT NUMBER: 87K10
 LOCATION: River Pillar
 COORDINATES: 39840.93 N 38905.02 E

SURFACE ELEVATION: 1099.70

BORING DEPTH: 27'

DATE: 09/21/88

MSL ELEV	DEPTH FR LND SURF	SAMP DEPTH INTERVAL	TYPE	#	N Sec	REC (ft)	DESCRIPTION OF MATERIAL	CLASS	LABORATORY TESTS	DRILLING AND SAMPLING NOTES
1099.7	--0	1-3	SB	1	P	2.0	Brown poorly graded SAND w/silt, fine, dense, loose, top 6" w/organics (topsoil). (Windblown sand)	SP-SM		Many boulders, cobbles from 3 to 6 feet.
1094.7	--5	6-8	SB	2	10	1.5	Red brown silty SAND, fine-coarse w/fine sand coarse gravel, diamict. Top 6" cored cobble, well graded GRAVEL w/silt, fine-coarse gravel	SM, GW-GM		
1089.7	--10	10-12	SB	3	30	1.0	Red brown silty GRAVEL/SAND, coarse gravel w/fine to coarse, matrix supported gravel, cohesive, dense. Cuttings at 14', SILT, (Precambrian)	GM/SM		
1084.7	--15	15-17	SB	4	30	2.0	Light yellow, red brown SILT and silty SAND, very brittle, soft to hard, little moisture (Altered schist)		Bail Test Permeability: K=1.2 x 10E-5 cm/sec	
1079.7	--20	20-22	SB	5	70	2.0	As above	SM and ML		
1074.7	--25	25-27	SB	6	80	2.0	Dusky red w/ white SILT and silty SAND as above, last 8" mostly very pale green w/ bright green and white sugary (quartz?) laminae			
1069.7	--30						27.0'-End of Boring			
1064.7	--35									
1059.7	--40									
1054.7	--45									
1049.7	--50									
1044.7	--55									

DRILLING DATA

START DATE: 09/21/88
 COMPLETION DATE: 09/21/88
 LOGGED BY: BJS
 DRILLING METHOD: Mud Rotary, 6" bit
 DRILLING CONTRACTOR: Luisier Well Drilling, Inc.

WATER LEVEL INFORMATION

DEPTH AT COMPLETION:
 LATER TIME/DEPTH:
 LATER TIME/DEPTH:
 CAVE IN DEPTH:
 DRILLING LOSSES:

MONITORING WELL CONSTRUCTION DIAGRAM

WELL NO: PZ-K8
 DATE INSTALLED: 9-21-88
 DRILLER: Luisier Drilling, Inc.
 DRILLING METHOD: Mud Rotary
 COORDINATES: 39,855.80N 38902.96E


CLIENT: Kennecott
 PROJECT: Pit Inflow
 SCOPE I.D.: 87K10
 BY: BJS

PROTECTOR PIPE:
 SIZE 6"
 MATERIAL steel
 LOCK NO. 2121

PIPE:
 DIAMETER 2"
 MATERIAL PVC
 SCH. 80
 TYPE OF JOINTS Flush/threaded

SCREEN:
 DIAMETER 2"
 SLOT SIZE 0.01"
 LENGTH 5'

TYPE OF CAP PVC flat

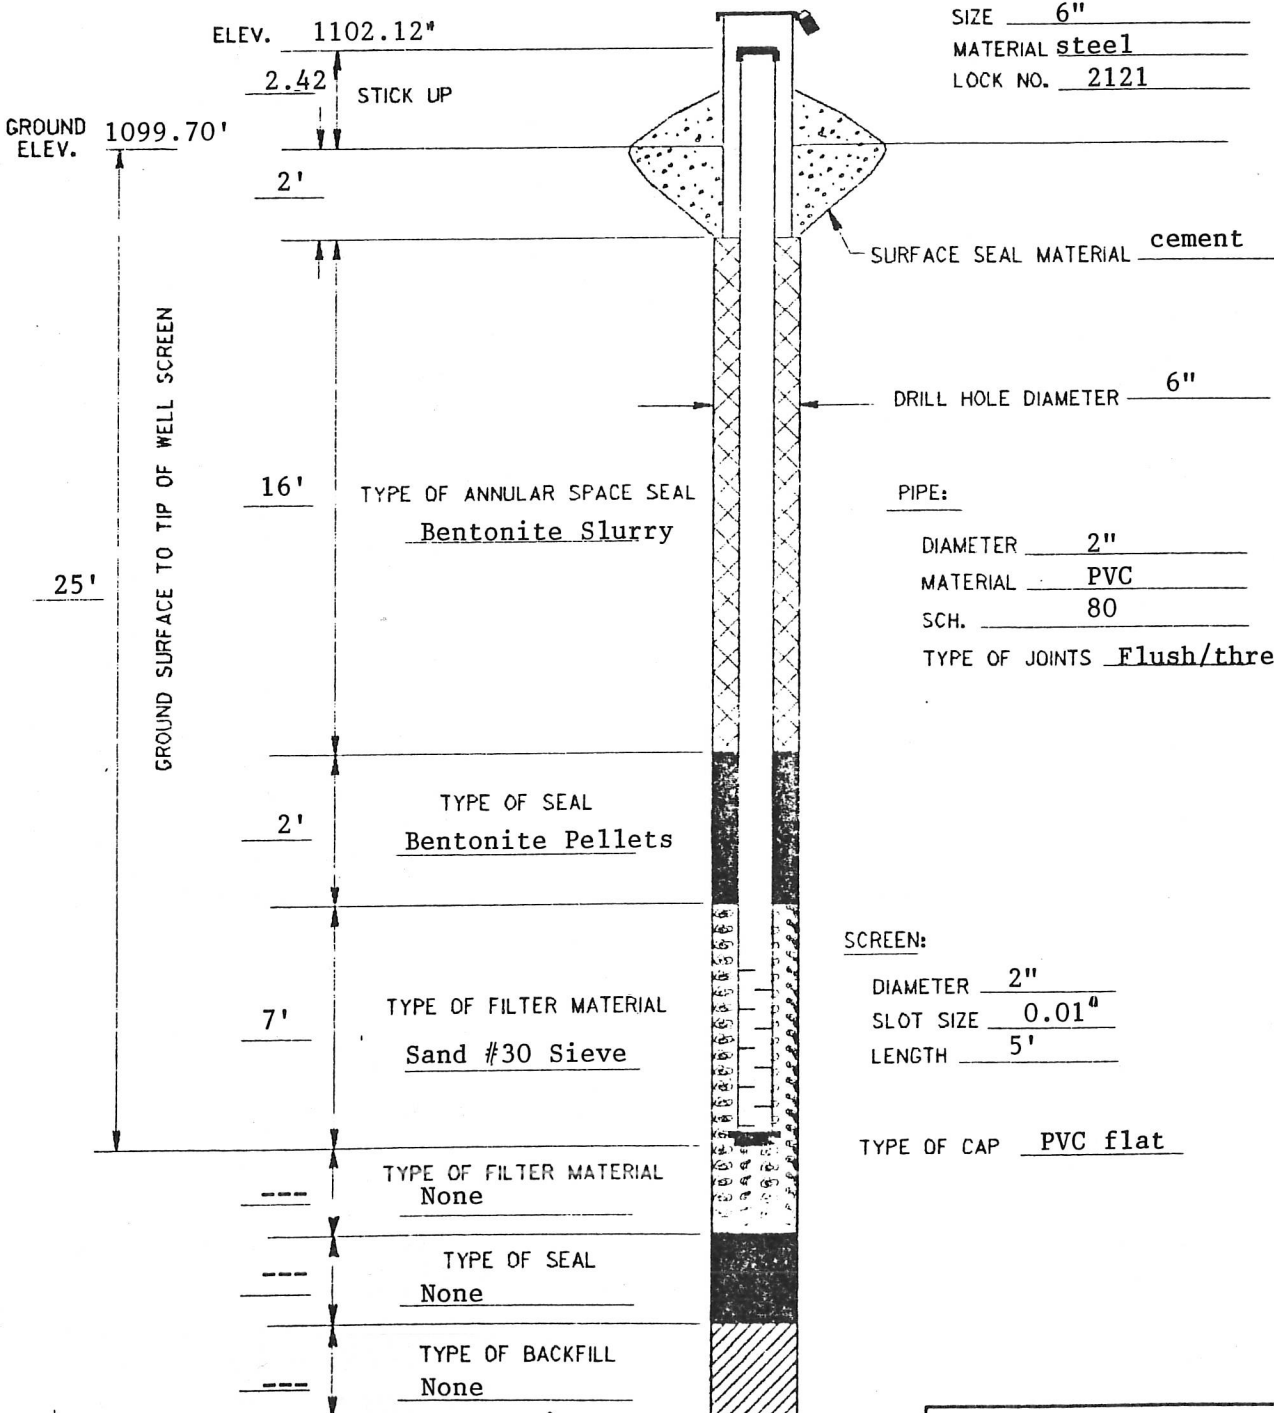

Foth & Van Dyke

Geosciences & Environmental
 Management Division
 Revised 3/88 By BJS
 Drawn By MRS

MONITORING WELL DEVELOPMENT

WELL NUMBER PZ-K8 CLIENT Kennecott
 WELL DIAMETER 2" PROJECT Pit Inflow
 TOTAL DEPTH OF WELL 25' SCOPE I.D. 87K10
 DEPTH TO WATER BEFORE 3.3' TIME OF MEASUREMENT 6:45 p.m. BY BJS
 AFTER 11.5' 7:19 p.m. DATE 9-21-88

DESCRIPTION OF DEVELOPMENT METHOD

Surged and bailed with PVC hand bailer.

VOLUME OF WATER REMOVED FROM WELL: 23 gallons
 CLARITY OF WATER IN WELL BEFORE DEVELOPMENT 1t. red brn. slightly silty
 CLARITY OF WATER IN WELL AFTER DEVELOPMENT 1t. red brn.
 PRESENCE OF SEDIMENT AT THE BOTTOM OF THE WELL slightly silty
 VOLUME OF WATER ADDED TO WELL None
 SOURCE OF WATER ADDED TO WELL ---
 TIME SPENT FOR DEVELOPMENT 30 Minutes

STABILIZATION READINGS


GAL. REMOVED	TIME	FIELD		
		TEMPERATURE	SPEC. COND.	pH
_____	_____	_____	_____	_____
_____	_____	_____	_____	_____
_____	_____	_____	_____	_____
_____	_____	_____	_____	_____

FOTH AND VAN DYKE

MONITORING WELL CONSTRUCTION DIAGRAM

WELL NO: TW-K17B
 DATE INSTALLED: 9-20-88
 DRILLER: Luisier Drilling, Inc.
 DRILLING METHOD: Air/Mud Rotary
 COORDINATES: 39,960.29N 38,746.15E

CLIENT: Kennecott
 PROJECT: Pit Inflow
 SCOPE I.D.: 87K10
 BY: BJS

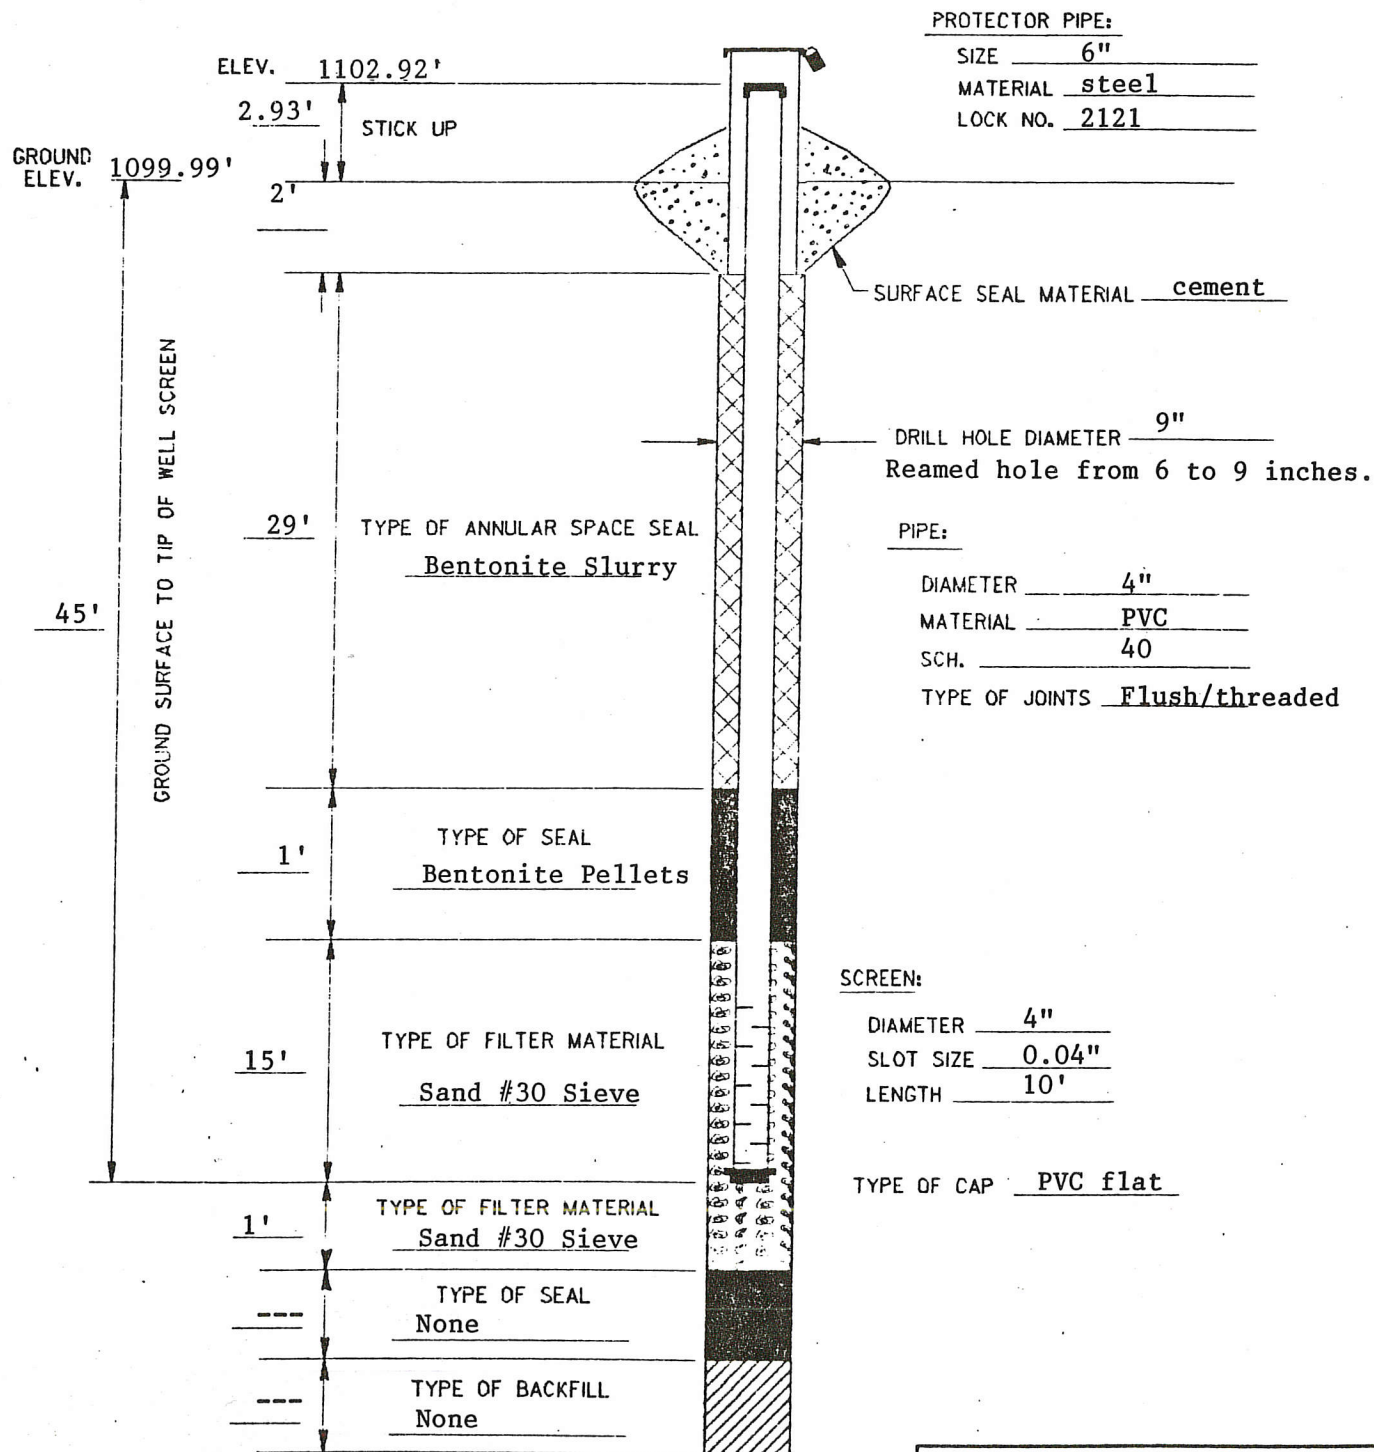

PROTECTOR PIPE:
 SIZE 6"
 MATERIAL steel
 LOCK NO. 2121

PIPE:
 DIAMETER 4"
 MATERIAL PVC
 SCH. 40
 TYPE OF JOINTS Flush/threaded

SCREEN:
 DIAMETER 4"
 SLOT SIZE 0.04"
 LENGTH 10'

TYPE OF CAP PVC flat

Foth & Van Dyke
 Geosciences & Environmental
 Management Division
 Revised 3/88 By BJS
 Drawn By MRS

MONITORING WELL DEVELOPMENT

WELL NUMBER TW-K17B CLIENT Kennecott
 WELL DIAMETER 4" PROJECT Pit Inflow
 TOTAL DEPTH OF WELL 45' SCOPE I.D. 88K10
 DEPTH TO WATER _____ TIME OF MEASUREMENT _____ BY BJS
 BEFORE --- _____ DATE 9-20-88
 AFTER --- _____

DESCRIPTION OF DEVELOPMENT METHOD

Surged with air starting at 4:55 p.m. to 5:00 p.m.
 Blew out about 15 gpm from 5:00 to 5:08 p.m.
 Jetted with air while pulling drill rod up and down in sand packed interval.
 Jetted from 5:08 to 5:16 p.m. Blew out about 20 gpm from 5:16 to 5:23 p.m.
 On 9-21-88 pumped out about 800 gallons at about 15 gpm.

VOLUME OF WATER REMOVED FROM WELL 400 gallons
 CLARITY OF WATER IN WELL BEFORE DEVELOPMENT lt red brn. silty
 CLARITY OF WATER IN WELL AFTER DEVELOPMENT clear
 PRESENCE OF SEDIMENT AT THE BOTTOM OF THE WELL none
 VOLUME OF WATER ADDED TO WELL none
 SOURCE OF WATER ADDED TO WELL ---
 TIME SPENT FOR DEVELOPMENT 30 Minutes

STABILIZATION READINGS

GAL. REMOVED	TIME	TEMPERATURE	SPEC. COND.	PH
_____	_____	_____	_____	_____
_____	_____	_____	_____	_____
FOTH AND VAN DYKE